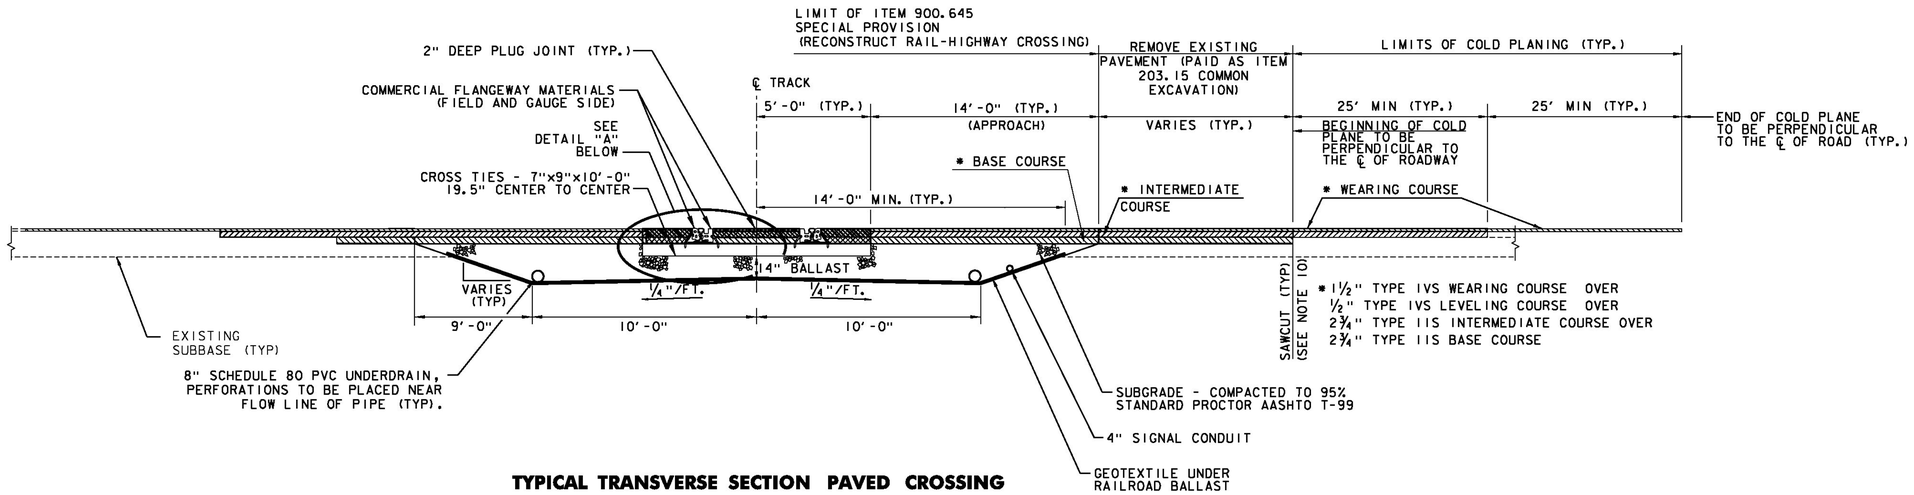

TYPICAL TRANSVERSE SECTION PAVED CROSSING

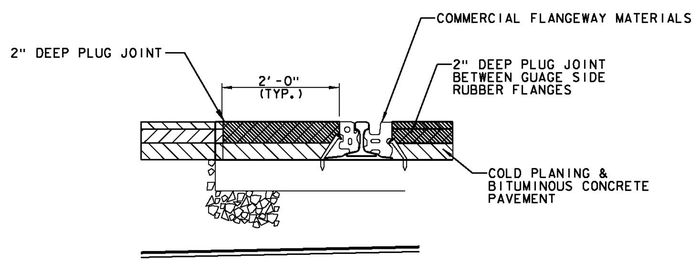

DETAIL "A"

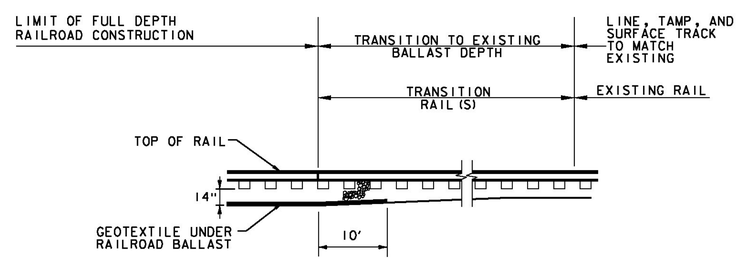

TYPICAL BALLAST TRANSITION

NOT TO SCALE

AARDOT #850-938H

RAILROAD CROSSING DETAIL SHEET #8

PROJECT NAME: ST JOHNSBURY - LYNDON
PROJECT NUMBER: STP 2936(1)

FILE NAME: pllc308.dgn
PROJECT LEADER: G. EDWARDS
DESIGNED BY: D. DRAPER

PLOT DATE: 5/5/2014
DRAWN BY: D. DRAPER
CHECKED BY: J. LITTLE
SHEET 39 OF 250

Stantec