

CHANGING ELEVATION OF DIS., CBS OR MHS  
SEE SHEET 27

REHAB.  
DIS., CBS OR MHS, CLASS I, II OR III  
SEE SHEETS 27-28

CHANGING ELEVATION OF SEWER MANHOLES  
SEE SHEET 28

CAST-IN-PLACE CONCRETE CURB, TYPE B  
STA. 221+77, RT  
STA. 222+56, RT

REMOVAL OF EXISTING CURB  
STA. 221+77, RT  
STA. 222+56, RT

PORTLAND CEMENT  
CONCRETE SIDEWALK, 5 INCH  
STA. 220+14, LT  
STA. 220+80, LT  
STA. 221+00, LT  
STA. 221+77, RT  
STA. 222+56, RT

DETECTABLE WARNING SURFACE  
STA. 220+14, LT  
STA. 220+80, LT  
STA. 221+00, LT  
STA. 221+77, RT  
STA. 221+77, LT  
STA. 222+56, RT

ADJUST ELEVATION OF VALVE BOX  
SEE SHEETS 28-29

DURABLE & TEMPORARY 4 INCH WHITE LINE  
(ALL LINES WILL INCLUDE EDGE LINE BREAKS AND RADI FOR SIDE ROADS)  
STA. 220+00 TO 225+00, SOLID LT & RT  
STA. 221+72, SOLID LT (EDGELINES, CONCORD AVE.)  
STA. 220+00 TO 220+65, DOTTED RT  
STA. 220+65 TO 221+27, SOLID RT (LANE LINE)  
STA. 222+59 TO 223+09, SOLID LT (LANE LINE)  
STA. 223+09 TO 224+09, DOTTED LT


DURABLE & TEMPORARY 4 INCH YELLOW LINE  
(ALL LINES WILL INCLUDE  $\frac{1}{4}$  BREAKS FOR SIDE ROADS & CROSSWALKS)  
STA. 220+00 TO 220+65, DOUBLE SOLID LT & RT  
STA. 220+65 TO 221+17, DOUBLE SOLID LT  
STA. 221+72, DOUBLE SOLID LT (CONCORD AVE.)  
STA. 221+89, DOUBLE SOLID RT (CONCORD AVE.)  
STA. 222+57 TO 223+09, DOUBLE SOLID RT  
STA. 223+09 TO 225+00, DOUBLE SOLID LT & RT

DURABLE & TEMPORARY 8 INCH WHITE LINE  
STA. 221+72, SOLID LT (GORE) (CONCORD AVE.)  
SEE SHEET 55  
DURABLE & TEMPORARY 8 INCH YELLOW LINE  
STA. 220+00 TO 220+47, LT (DIAGONALS)  
STA. 223+31 TO 224+87, LT & RT (DIAGONALS)  
SEE SHEET 55

DURABLE & TEMPORARY 24 INCH STOP BAR  
STA. 221+16, LT-RT  
STA. 221+28, RT  
STA. 221+77, LT (CONCORD AVE.)  
STA. 221+89, RT (CONCORD AVE.)  
STA. 222+58, LT-RT  
DURABLE & TEMPORARY LETTER OR SYMBOL  
STA. 220+69, RT ARROW  
STA. 220+71.5, RT ARROWS (2)  
STA. 220+52 TO 220+72, LT YIELD BAR (7)  
SEE SHEET 55  
STA. 221+07, RT ARROW  
STA. 221+16.5, RT ARROWS (2)  
STA. 222+67, LT ARROW  
STA. 222+70, LT ARROWS (2)  
STA. 223+02.5, LT ARROWS (2)  
STA. 223+05, LT ARROW

DURABLE CROSSWALK MARKING, TYPE A TAPE  
STA. 220+25 TO 220+74, LT  
STA. 221+72, LT (CONCORD AVE.)  
STA. 221+76, LT-221+77, RT  
STA. 221+89, RT (CONCORD AVE.)  
SEE SHEET 55 (TYP.)  
TEMPORARY CROSSWALK MARKING, PAINT  
STA. 220+25 TO 220+74, LT  
STA. 221+72, LT (CONCORD AVE.)  
STA. 221+76, LT-221+77, RT  
STA. 221+89, RT (CONCORD AVE.)  
SEE SHEET 55 (TYP.)

REMOVING SIGNS  
AS SHOWN - 25

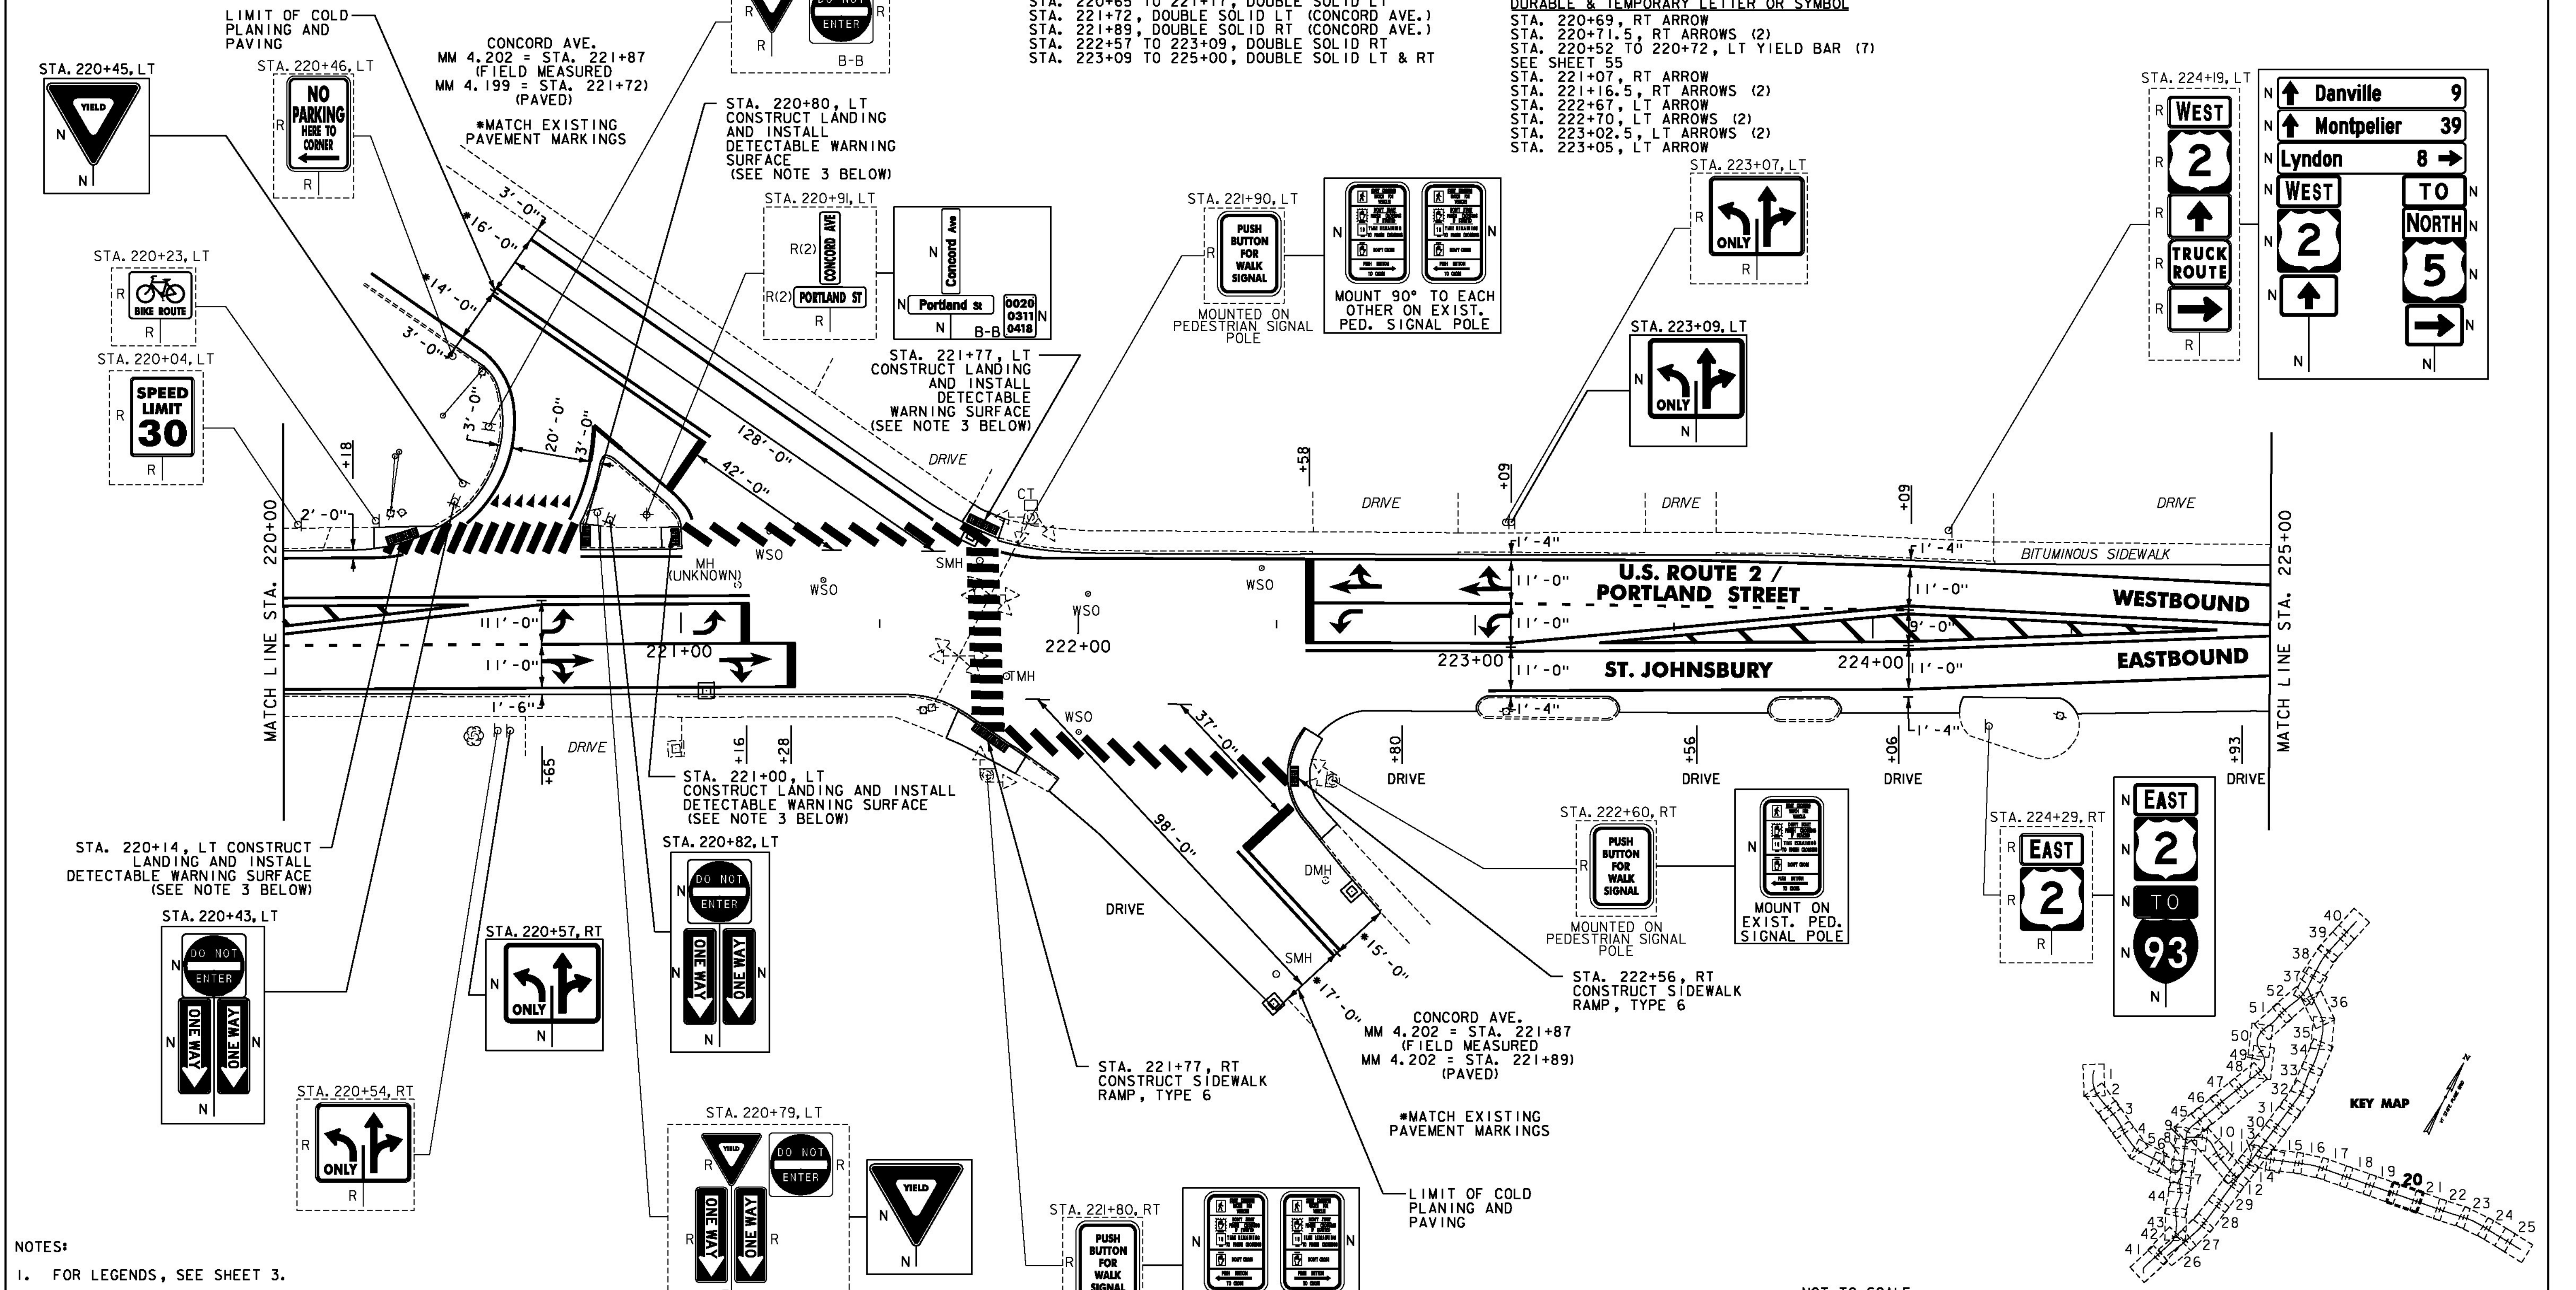

- NOTES:
- FOR LEGENDS, SEE SHEET 3.
  - ALL EXISTING SIGNS NOT SHOWN ON THE PLANS SHALL BE RETAINED.
  - THE SIDEWALK "LANDINGS" NOTED CONSIST OF THE REMOVAL AND REPLACEMENT OF A SINGLE SLAB OF CONCRETE SIDEWALK IN ORDER TO INSTALL A NEW DETECTABLE WARNING SURFACE. SEE SHEETS 12-25.
  - SEE SHEET 242 FOR TRAFFIC SIGNAL DETAILS.

NOT TO SCALE

<b>PROJECT LAYOUT SHEET #20</b>	PROJECT NAME: ST JOHNSBURY - LYNDON	PLOT DATE: 5/5/2014
	PROJECT NUMBER: STP 2936(1)	DRAWN BY: D. DRAPER
	FILE NAME: pllc308.dgn	CHECKED BY: J. LITTLE
	DESIGNED BY: D. DRAPER	SHEET 82 OF 250

