THINNING AND TRIMMING FOR SIGNS
STA. 17+80, RT
SEE SHEET 241 (TYP.)

CHANGING ELEVATION OF DIs, CBs OR MHs
SEE SHEET 27

REHAB,
DIs, CBs OR MHs, CLASS I, II OR III
SEE SHEETS 27-28

DURABLE & TEMPORARY 4 INCH WHITE LINE
(ALL LINES WILL INCLUDE EDGE LINE BREAKS AND RADII FOR SIDE ROADS)
STA. 16+25 TO 21+00, SOLID LT & RT

DURABLE & TEMPORARY 4 INCH YELLOW LINE
(ALL LINES WILL INCLUDE ℄ BREAKS FOR SIDE ROADS)
STA. 16+25 TO 21+00, SOLID LT & RT

REMOVING SIGNS
AS SHOWN - 1

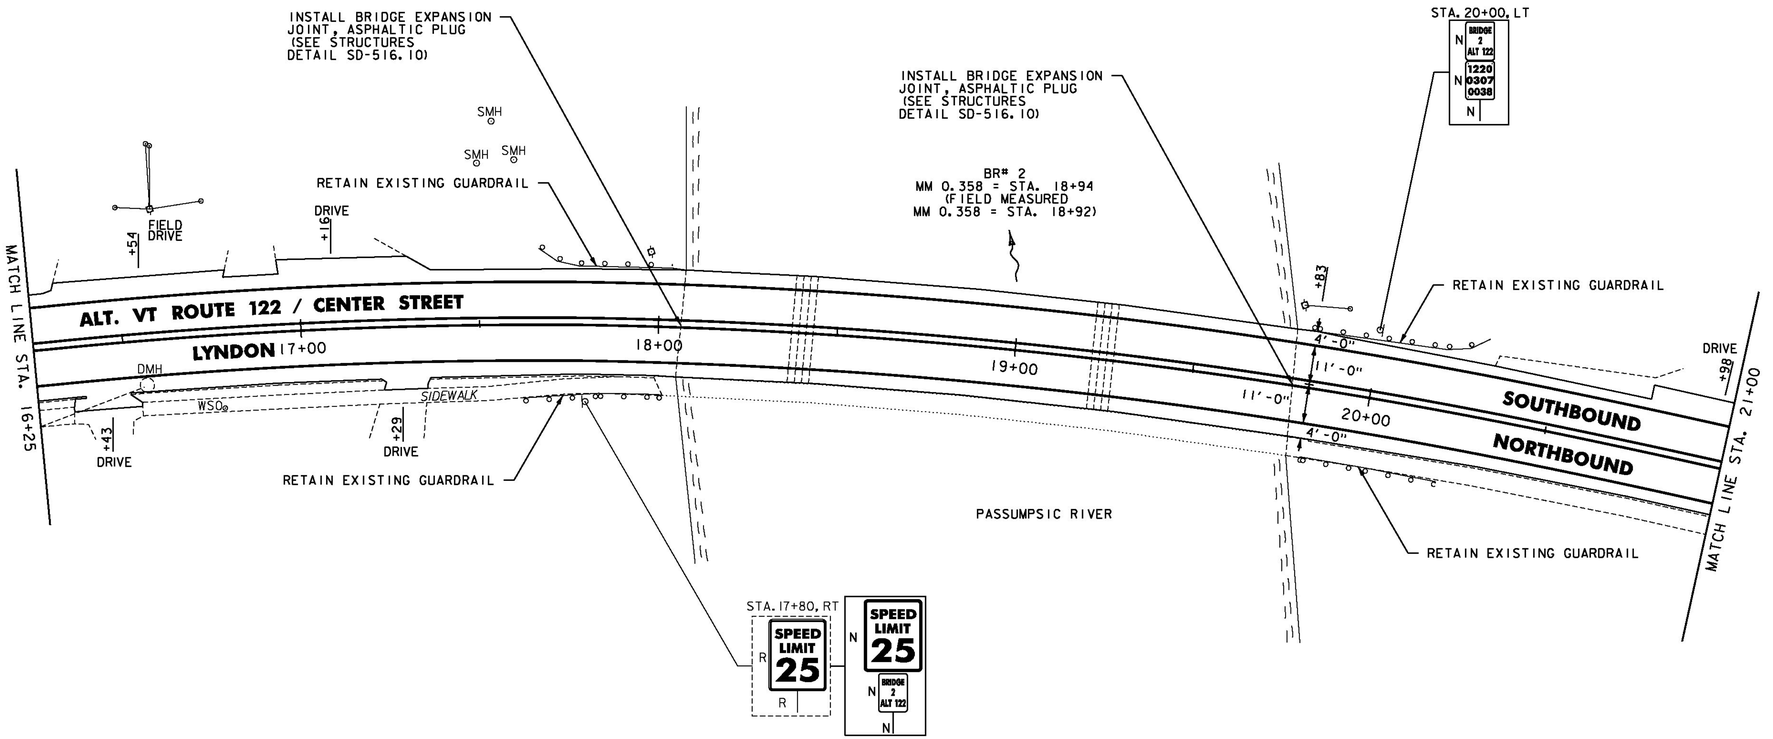

NOTES:

1. FOR LEGENDS, SEE SHEET 3.
2. ALL EXISTING SIGNS NOT SHOWN ON THE PLANS SHALL BE RETAINED.

NOT TO SCALE

Stantec

PROJECT LAYOUT SHEET #67

PROJECT NAME: ST JOHNSBURY - LYNDON
PROJECT NUMBER: STP 2936(I)

FILE NAME: plic308.dgn
PROJECT LEADER: G. EDWARDS
DESIGNED BY: D. DRAPER
PLOT DATE: 5/5/2014
DRAWN BY: D. DRAPER
CHECKED BY: J. LITTLE
SHEET 134 OF 250