STATE OF VERMONT
AGENCY OF TRANSPORTATION

TRAFFIC SIGN SUMMARY SHEET 29

MILEMARKER, STATION, OR SIGN NUMBER	SIGN LEGEND	SIGN DIMENSIONS EA	WIDTH (in)	HEIGHT (in)	NEW & SALVAGED SIGNS "A"	"B"	SALV SIGN	SALV TIS	EXIST POST RETAIN	SALVAGE	NEW SIGN POSTS NO. OF POSTS	FLANGED CHANNEL lb/ft 1.12	2.0	3.0	SQUARE STEEL (in) lb/ft 1.75	2.0	2.5	ANCHOR	SLEEVE	TUBULAR ALUMINUM Ø (in) lb/ft 3.0	4.0	4.0 MOD	TUBULAR STEEL Ø (in) FOUND-ATION	lb/ft 3.0	3.5	4.0	5.0	W-SHAPE STEEL FTG. SIZE 24"	30"	WEIGHT	POST SIZE	SIGN FRAME REQUIRED	REMARKS	SIGN DETAIL DETAIL IN SHSM * BOOK	DETAIL ON SHEET NUMBER	STD. SHEET NUMBER
ST. JOHNSBURY U.S. ROUTE 5 (CONT.)																																				
84+43, RT		1	21	15	2.19						1					X		X														M2-1 (BLACK ON WHITE)	X		
		1	24	24	4.00																											M1-4	X		
84+60, LT		1	24	30	5.00						1					X		X														R2-1	X		
85+46, LT		1	30	8	1.68						1					X		X														D3-1		229	
		1	36	8	2.01																											D3-1		230	
		1	30	30	6.25																											R1-1	X		
		1	6	10	0.42																											VD-700			E-138
85+79, RT		1	72	12	6.00						2						X	X														VD1-1a		234	
		1	72	12	6.00																											VD1-1a USE SOIL BEARING SLIP BASES. PAID AS ITEM 900.620 SPECIAL PROVISION (SOIL BEARING SLIP BASE) (2½")		234	
		1	72	12	6.00																											VD1-1a		233	
		1	24	24	4.00																													239	
		1	21	15	2.19																											M6-1 (WHITE ON BLUE)	X		
85+82, LT	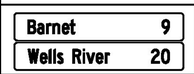	1	72	12	6.00						2					X		X														VD2-1		234	
		1	72	12	6.00																											VD2-1		235	
85+83, LT							1				1					X		X														MOUNT SALVAGED SIGNS ON NEW POST			
							1																													