


FOR ALL CONSTRUCTION NOTES
SEE SHEET 122

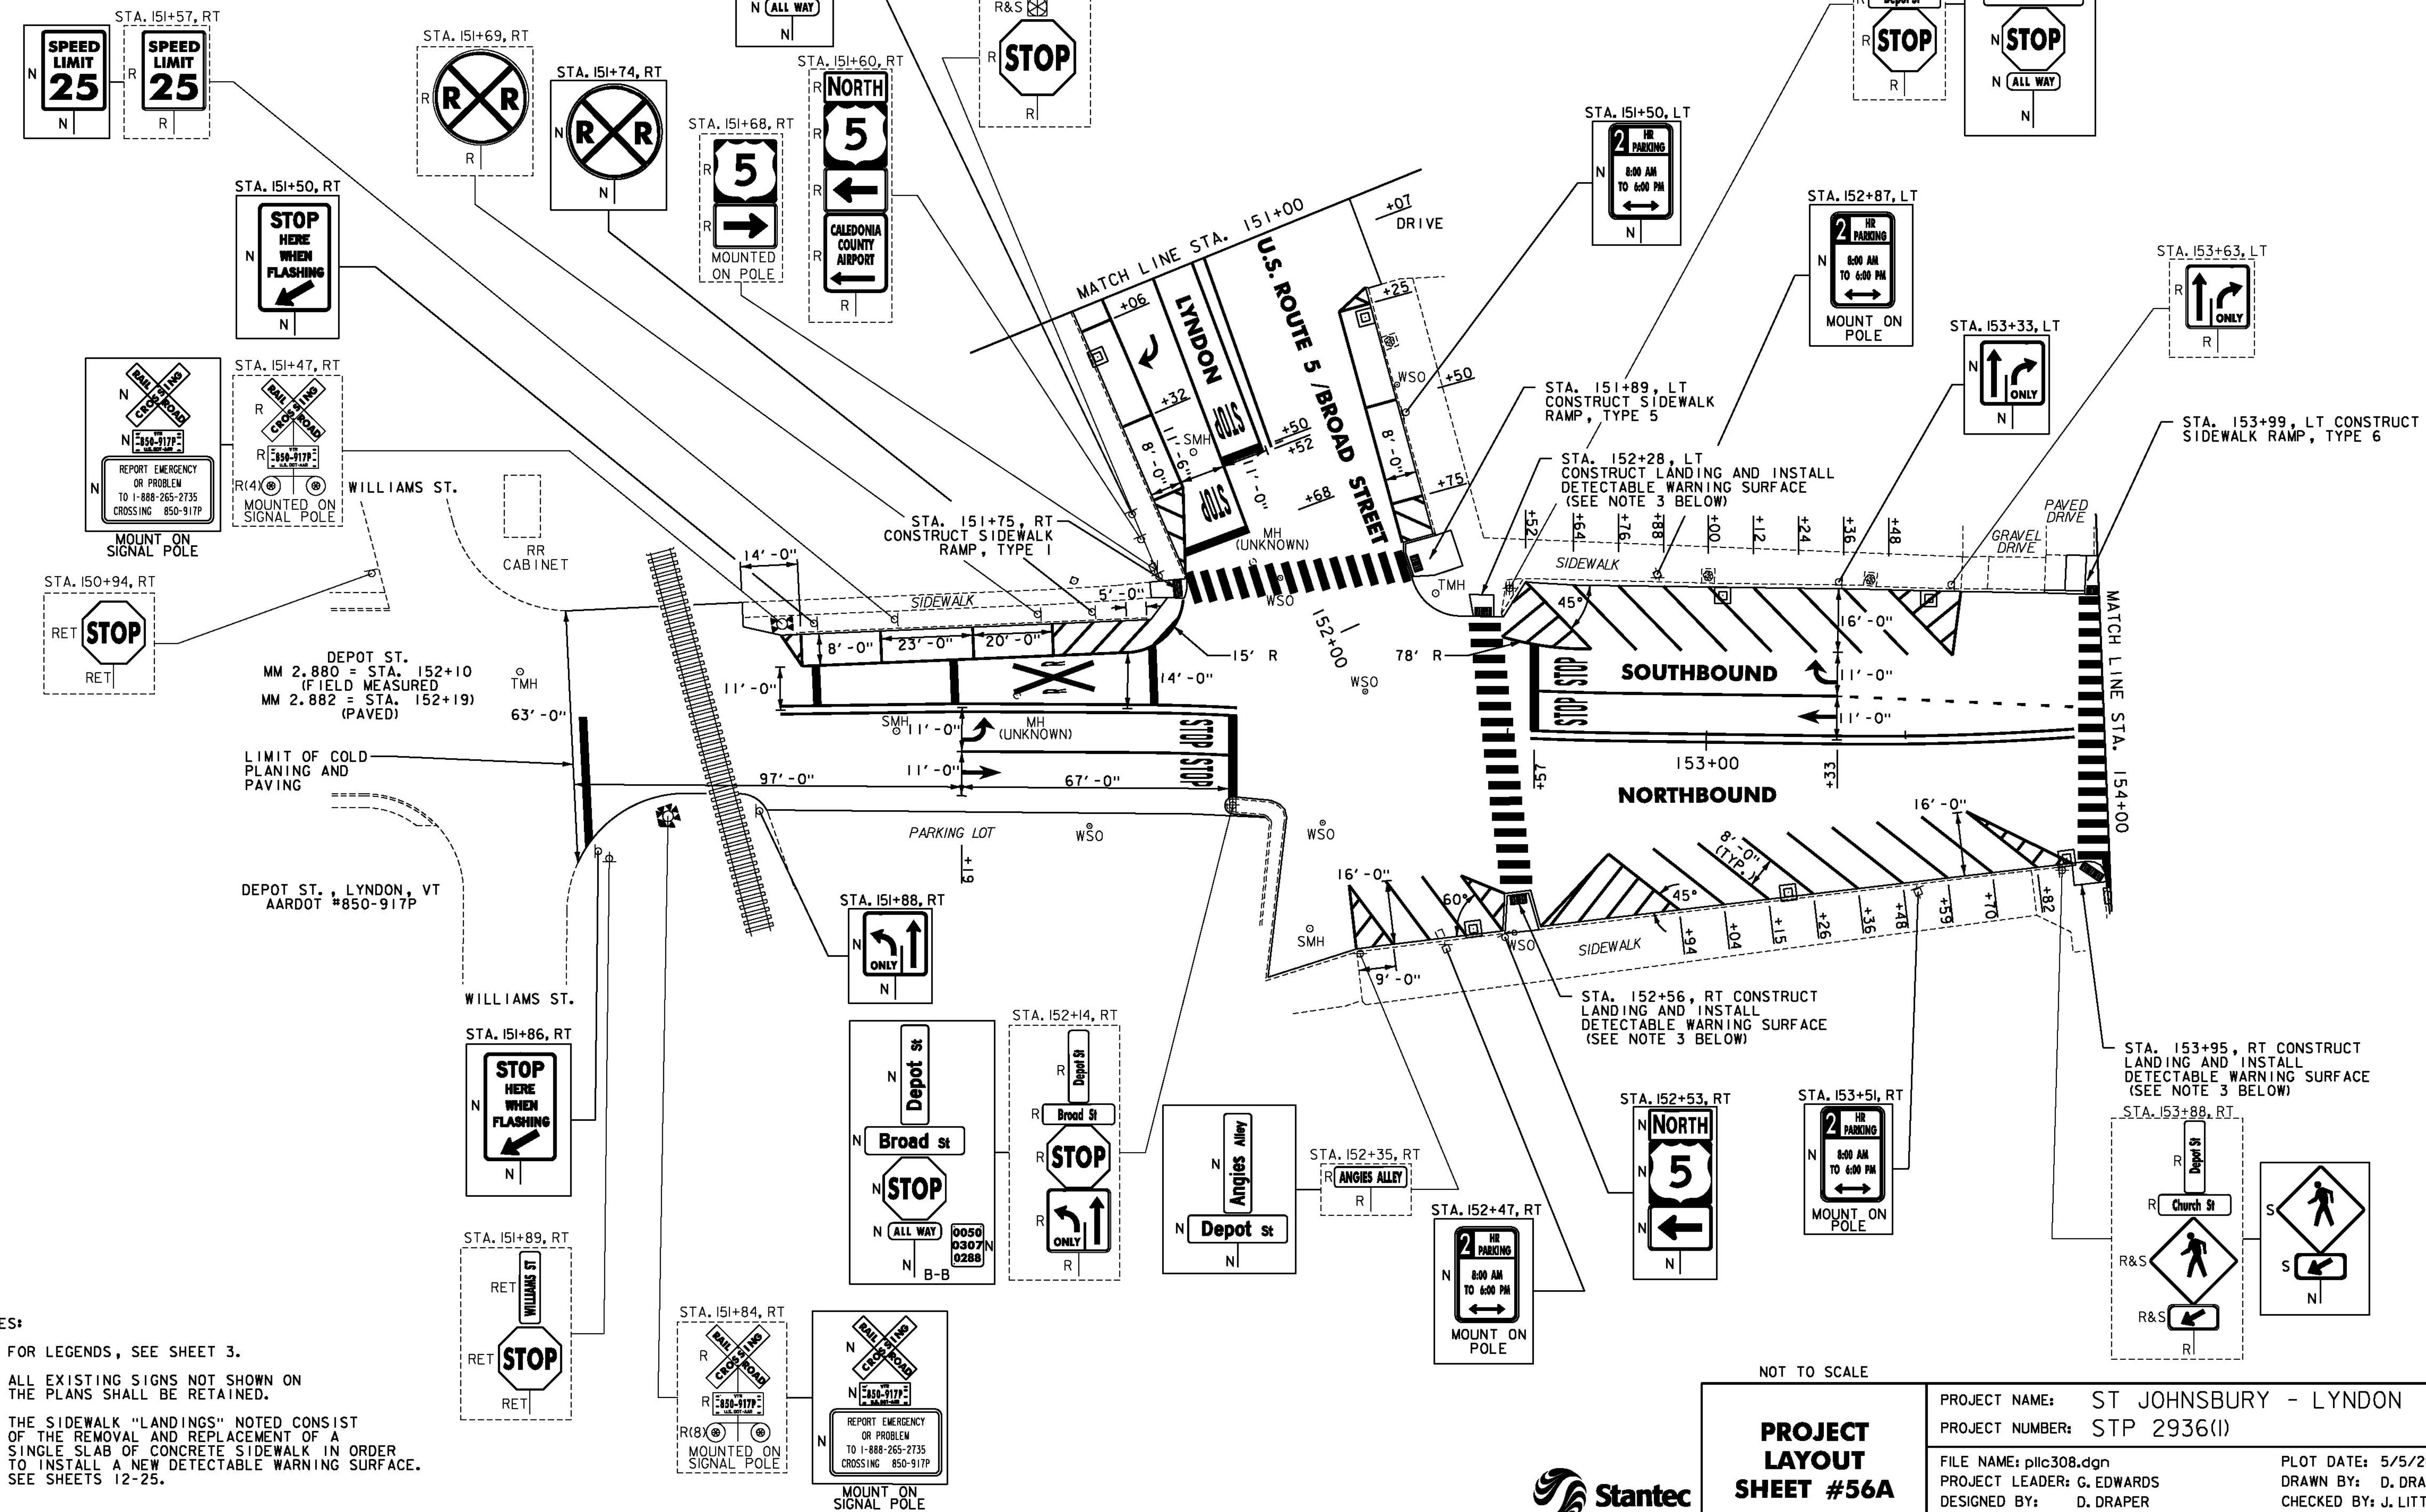

- NOTES:
- FOR LEGENDS, SEE SHEET 3.
 - ALL EXISTING SIGNS NOT SHOWN ON THE PLANS SHALL BE RETAINED.
 - THE SIDEWALK "LANDINGS" NOTED CONSIST OF THE REMOVAL AND REPLACEMENT OF A SINGLE SLAB OF CONCRETE SIDEWALK IN ORDER TO INSTALL A NEW DETECTABLE WARNING SURFACE. SEE SHEETS 12-25.
 - SEE SHEET 53 FOR RAILROAD CROSSING DETAILS.



NOT TO SCALE

**PROJECT
LAYOUT
SHEET #56A**

PROJECT NAME: ST JOHNSBURY - LYNDON	
PROJECT NUMBER: STP 2936(I)	
FILE NAME: pllc308.dgn	PLOT DATE: 5/5/2014
PROJECT LEADER: G. EDWARDS	DRAWN BY: D. DRAPER
DESIGNED BY: D. DRAPER	CHECKED BY: J. LITTLE
SHEET 121 OF 250	