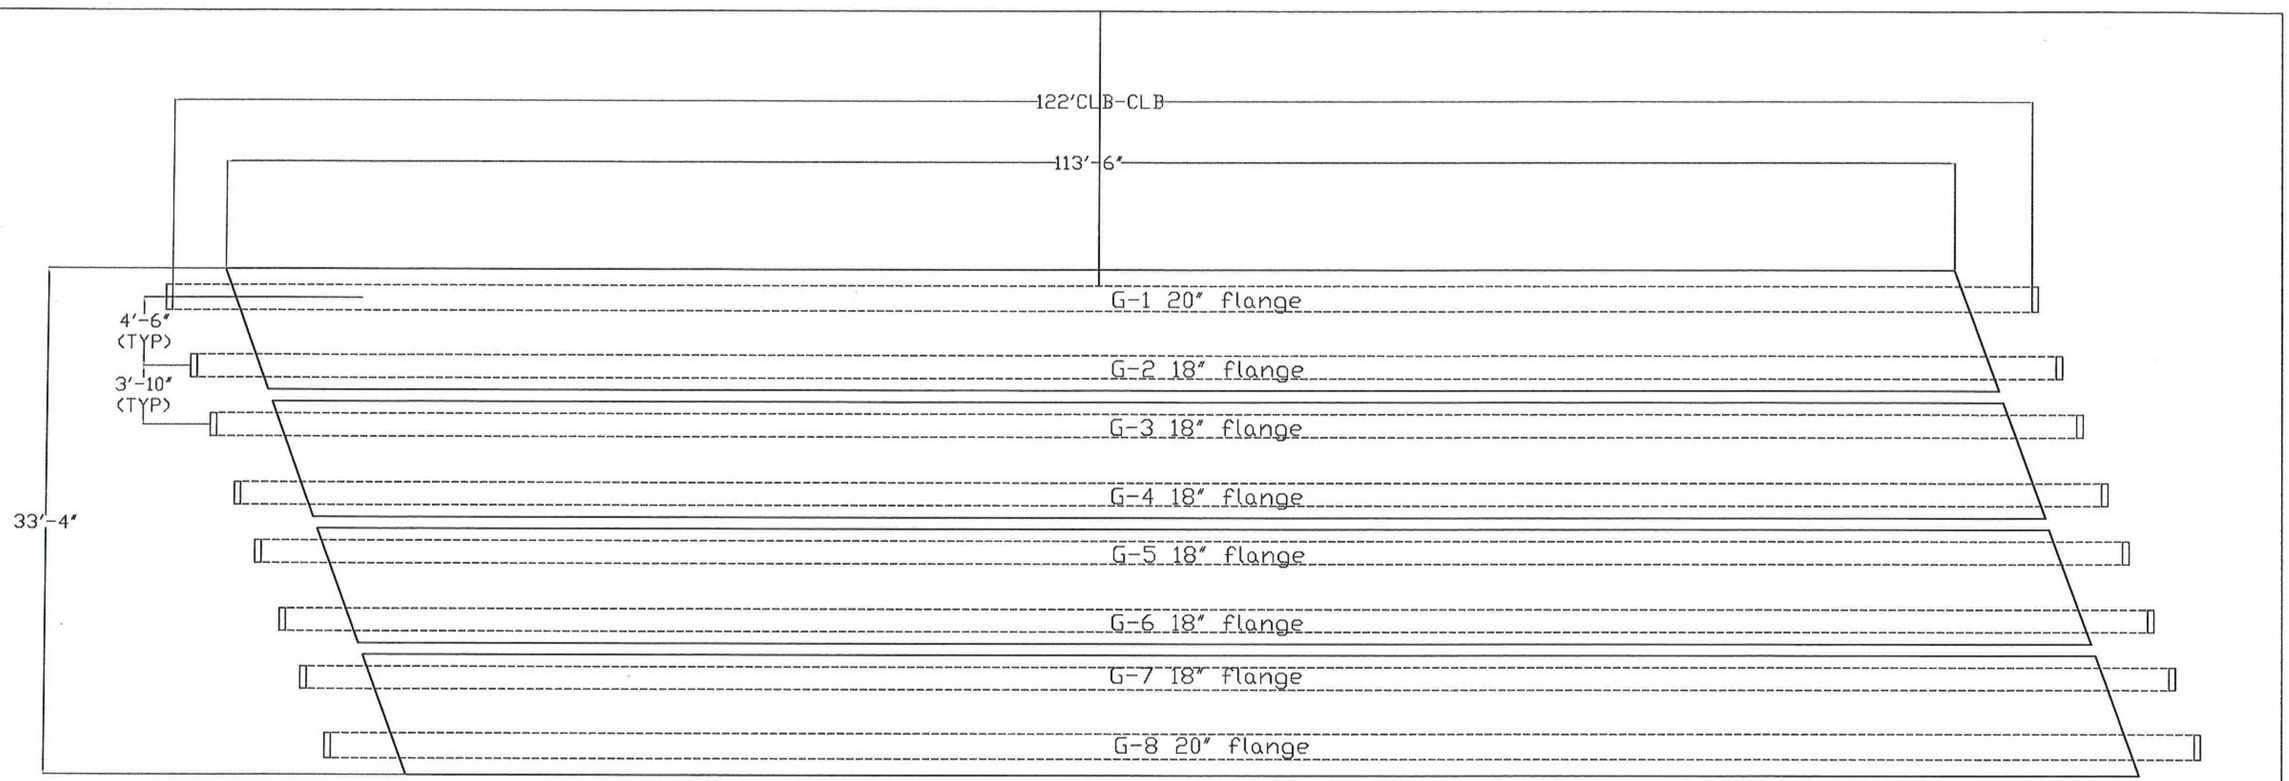

NOTES:
FINISHES
TOP-SCREED
SIDES-FORM WIRE BRUSH&POWER WASH
BOTTOM-FORM
ENDS-FORM WIRE BRUSH&POWER WASH

CONCRETE- VERMONT CLASS HPC A fc'-5000 psi @ 28 days

T.Y. LIN INTERNATIONAL

THE STAMPED DOCUMENTS ARE HEREBY:

__x__ APPROVED
____ APPROVED AS NOTED
____ REVISE AND RESUBMIT

SEE TRANSMITTAL FOR ADDITIONAL INFORMATION AS APPLICABLE.

THIS REVIEW IS FOR GENERAL CONFORMANCE WITH DESIGN CONCEPT ONLY. ANY DEVIATION FROM THE PLANS OR SPECIFICATIONS NOT CLEARLY NOTED BY THE CONTRACTOR HAS NOT BEEN REVIEWED. REVIEW BY THE ENGINEER SHALL NOT RELIEVE THE CONTRACTOR OF THE CONTRACTUAL RESPONSIBILITY FOR ANY ERRORS OR DEVIATION FROM THE CONTRACT REQUIREMENTS.

JOSH OLUND — REVIEWER
03/21/2014 — DATE

Vermont Agency of Transportation
RECEIVED
ON: March 17, 2014
and Checked for
CONFORMANCE
BY: Rob Young DATE: 03/24/2014

(REVISION #1 2/17/2014) (REVISION #2 3/17/2014)

COLD RIVER BRIDGES, LLC
10 LANBRO LANE
TEL 603-756-9300 WALPOLE, NH FAX 603-756-9303

CAVENDISH ER BRF 0146(13)

PBU PLAN

SHEET NUMBER 1

DATE: 2-17-14 scale: