SPLICE BAR - EXPANSION

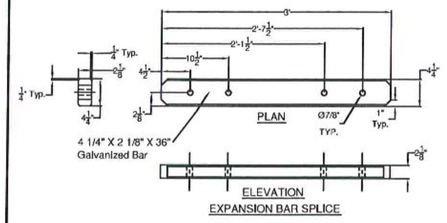

(ITEM # 9)

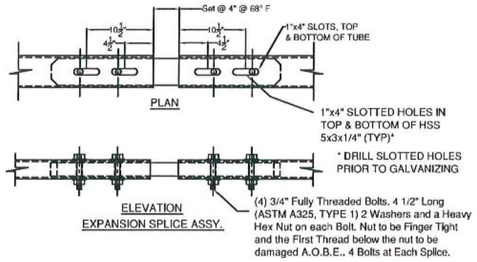

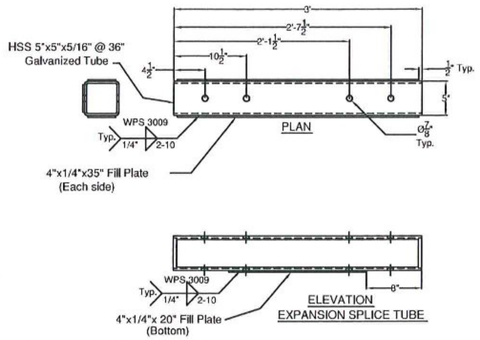

SPLICE TUBE - EXPANSION

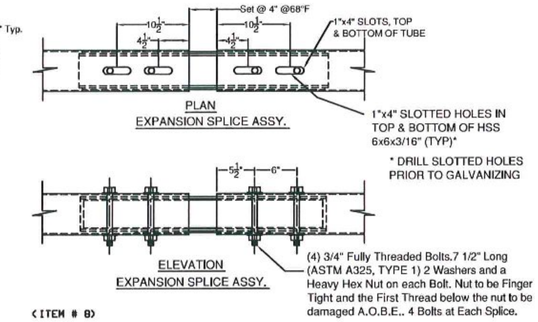

(ITEM # 8)

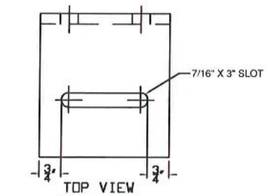

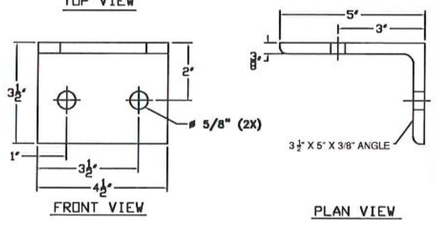

(ITEM # 10)

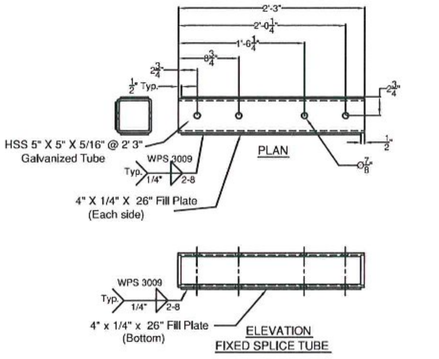

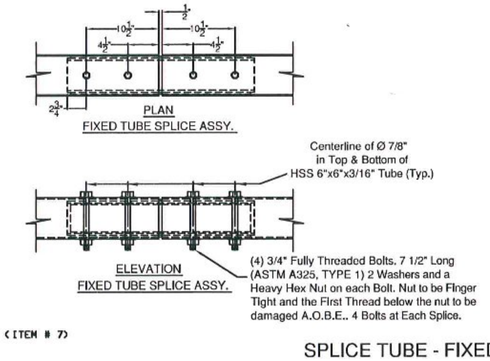

(ITEM # 7)

SPLICE TUBE - FIXED

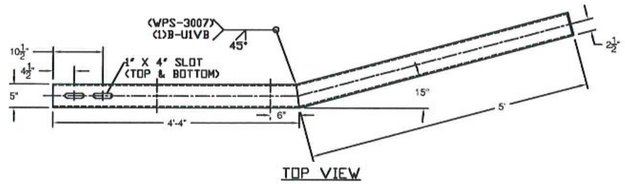

(ITEM # 6, WW 1, 2, 3 & 4)

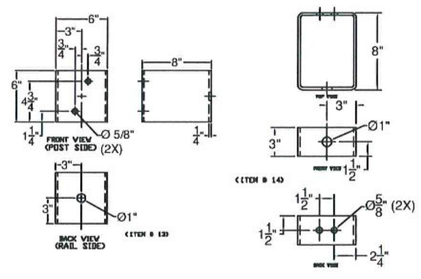

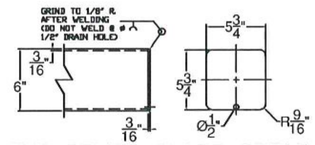

END COVER PLATE DETAIL

T.Y. LIN INTERNATIONAL

THE STAMPED DOCUMENTS ARE HEREBY:

__X__ APPROVED
____ APPROVED AS NOTED
____ REVISE AND RESUBMIT

SEE TRANSMITTAL FOR ADDITIONAL INFORMATION AS APPLICABLE.

THIS REVIEW IS FOR GENERAL CONFORMANCE WITH DESIGN CONCEPT ONLY. ANY DEVIATION FROM THE PLANS OR SPECIFICATIONS NOT CLEARLY NOTED BY THE CONTRACTOR HAS NOT BEEN REVIEWED. REVIEW BY THE ENGINEER SHALL NOT RELIEVE THE CONTRACTOR OF THE CONTRACTUAL RESPONSIBILITY FOR ANY ERRORS OR DEVIATION FROM THE CONTRACT REQUIREMENTS.

JOSH OLUND — REVIEWER
02/28/2014 — DATE

Vermont Agency of Transportation
RECEIVED
ON: February 28, 2014
and Checked for
CONFORMANCE
BY: Rob Young DATE: 03/07/2014

ITEM #: 621.725

F.R. LAFAYETTE, CAVENDISH

SHEET 10 OF 10

APPROVED BY:

GUARD RAIL TO BRIDGE RAIL TRANSITION DETAILS SHEET

CAVENDISH, ER BRF 0416 (13), ROUTE VT 131, OVER TWENTY MILE STREAM
VERMONT

R	NO.	DATE	DESCRIPTION	BY
E	1	2/17/14	REVISED PER 12/20/13 MARK-UP	EP
V	2	2/27/14	REVISED PER 2/18/14 MARK-UP	EP

R	NO.	DATE	DESCRIPTION	BY
E				
V				

ELDERLEE, INC.
OAKS CORNERS, NEW YORK 14518
E-Mail: dlong@elderlee.com
Tel: 315-789-6670 Fax: 315-789-6616

AISC CERTIFIED FABRICATOR

DRAWN	E.P.	11/13/13
CHECKED	D.L.	11/20/13
APPROVED	.	.
SCALE	SCHEMATIC	

DRAWING NO. F.R. LAFAYETTE, CAVENDISH