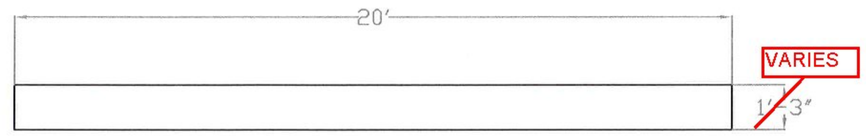


APPROACH SLAB 2 ELEVATION VIEW

~~APPROACH SLAB # 2 THICKNESS HAS BEEN CHANGED BY THE PROJECT MANAGER TO A CONSISTENT 1'-3"~~

CONSTANT THICKNESSES ALONG EDGES, BUT NOT CONSTANT THICKNESS OVERALL

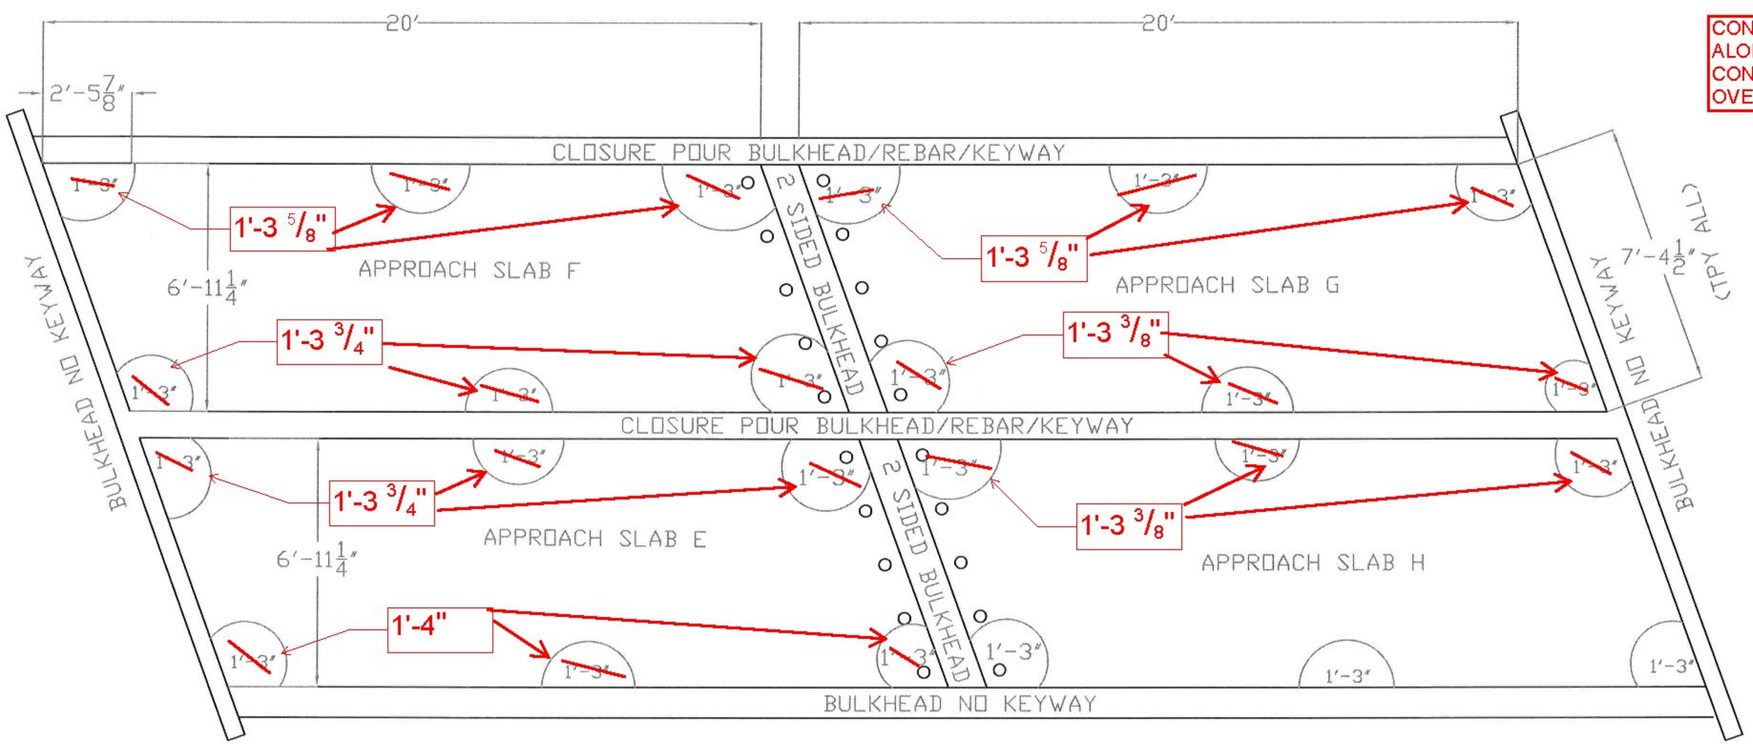


APPROACH SLABS E,F,G,H
CASTING LAY-OUT
REVISION # 1 11-19-13
REVISION # 2 12-6-13

| | |
|---|---|
| COLD RIVER BRIDGES, LLC<br>10 LANBRO LANE<br>TEL 603-756-9300 WALPOLE, NH FAX 603-756-9303 | |
| CAVENDISH ER BRF 0146(13) | |
| APPROACH SLAB 2 | SHEET NUMBER<br>8 |
| DATE: 10-2-13 scale: | |