


TEMPORARY 4 INCH WHITE LINE, PAINT  
 DURABLE 4 INCH WHITE LINE (OPTION BID ITEM)  
 W274+25 TO W285+50 SOLID LT & RT

TEMPORARY 4 INCH YELLOW LINE, PAINT  
 DURABLE 4 INCH YELLOW LINE (OPTION BID ITEM)  
 W274+25 TO W285+50 SOLID LT & RT

REMOVING SIGNS  
 AS SHOWN - 23

ERECTING SALVAGED SIGNS  
 AS SHOWN - 3

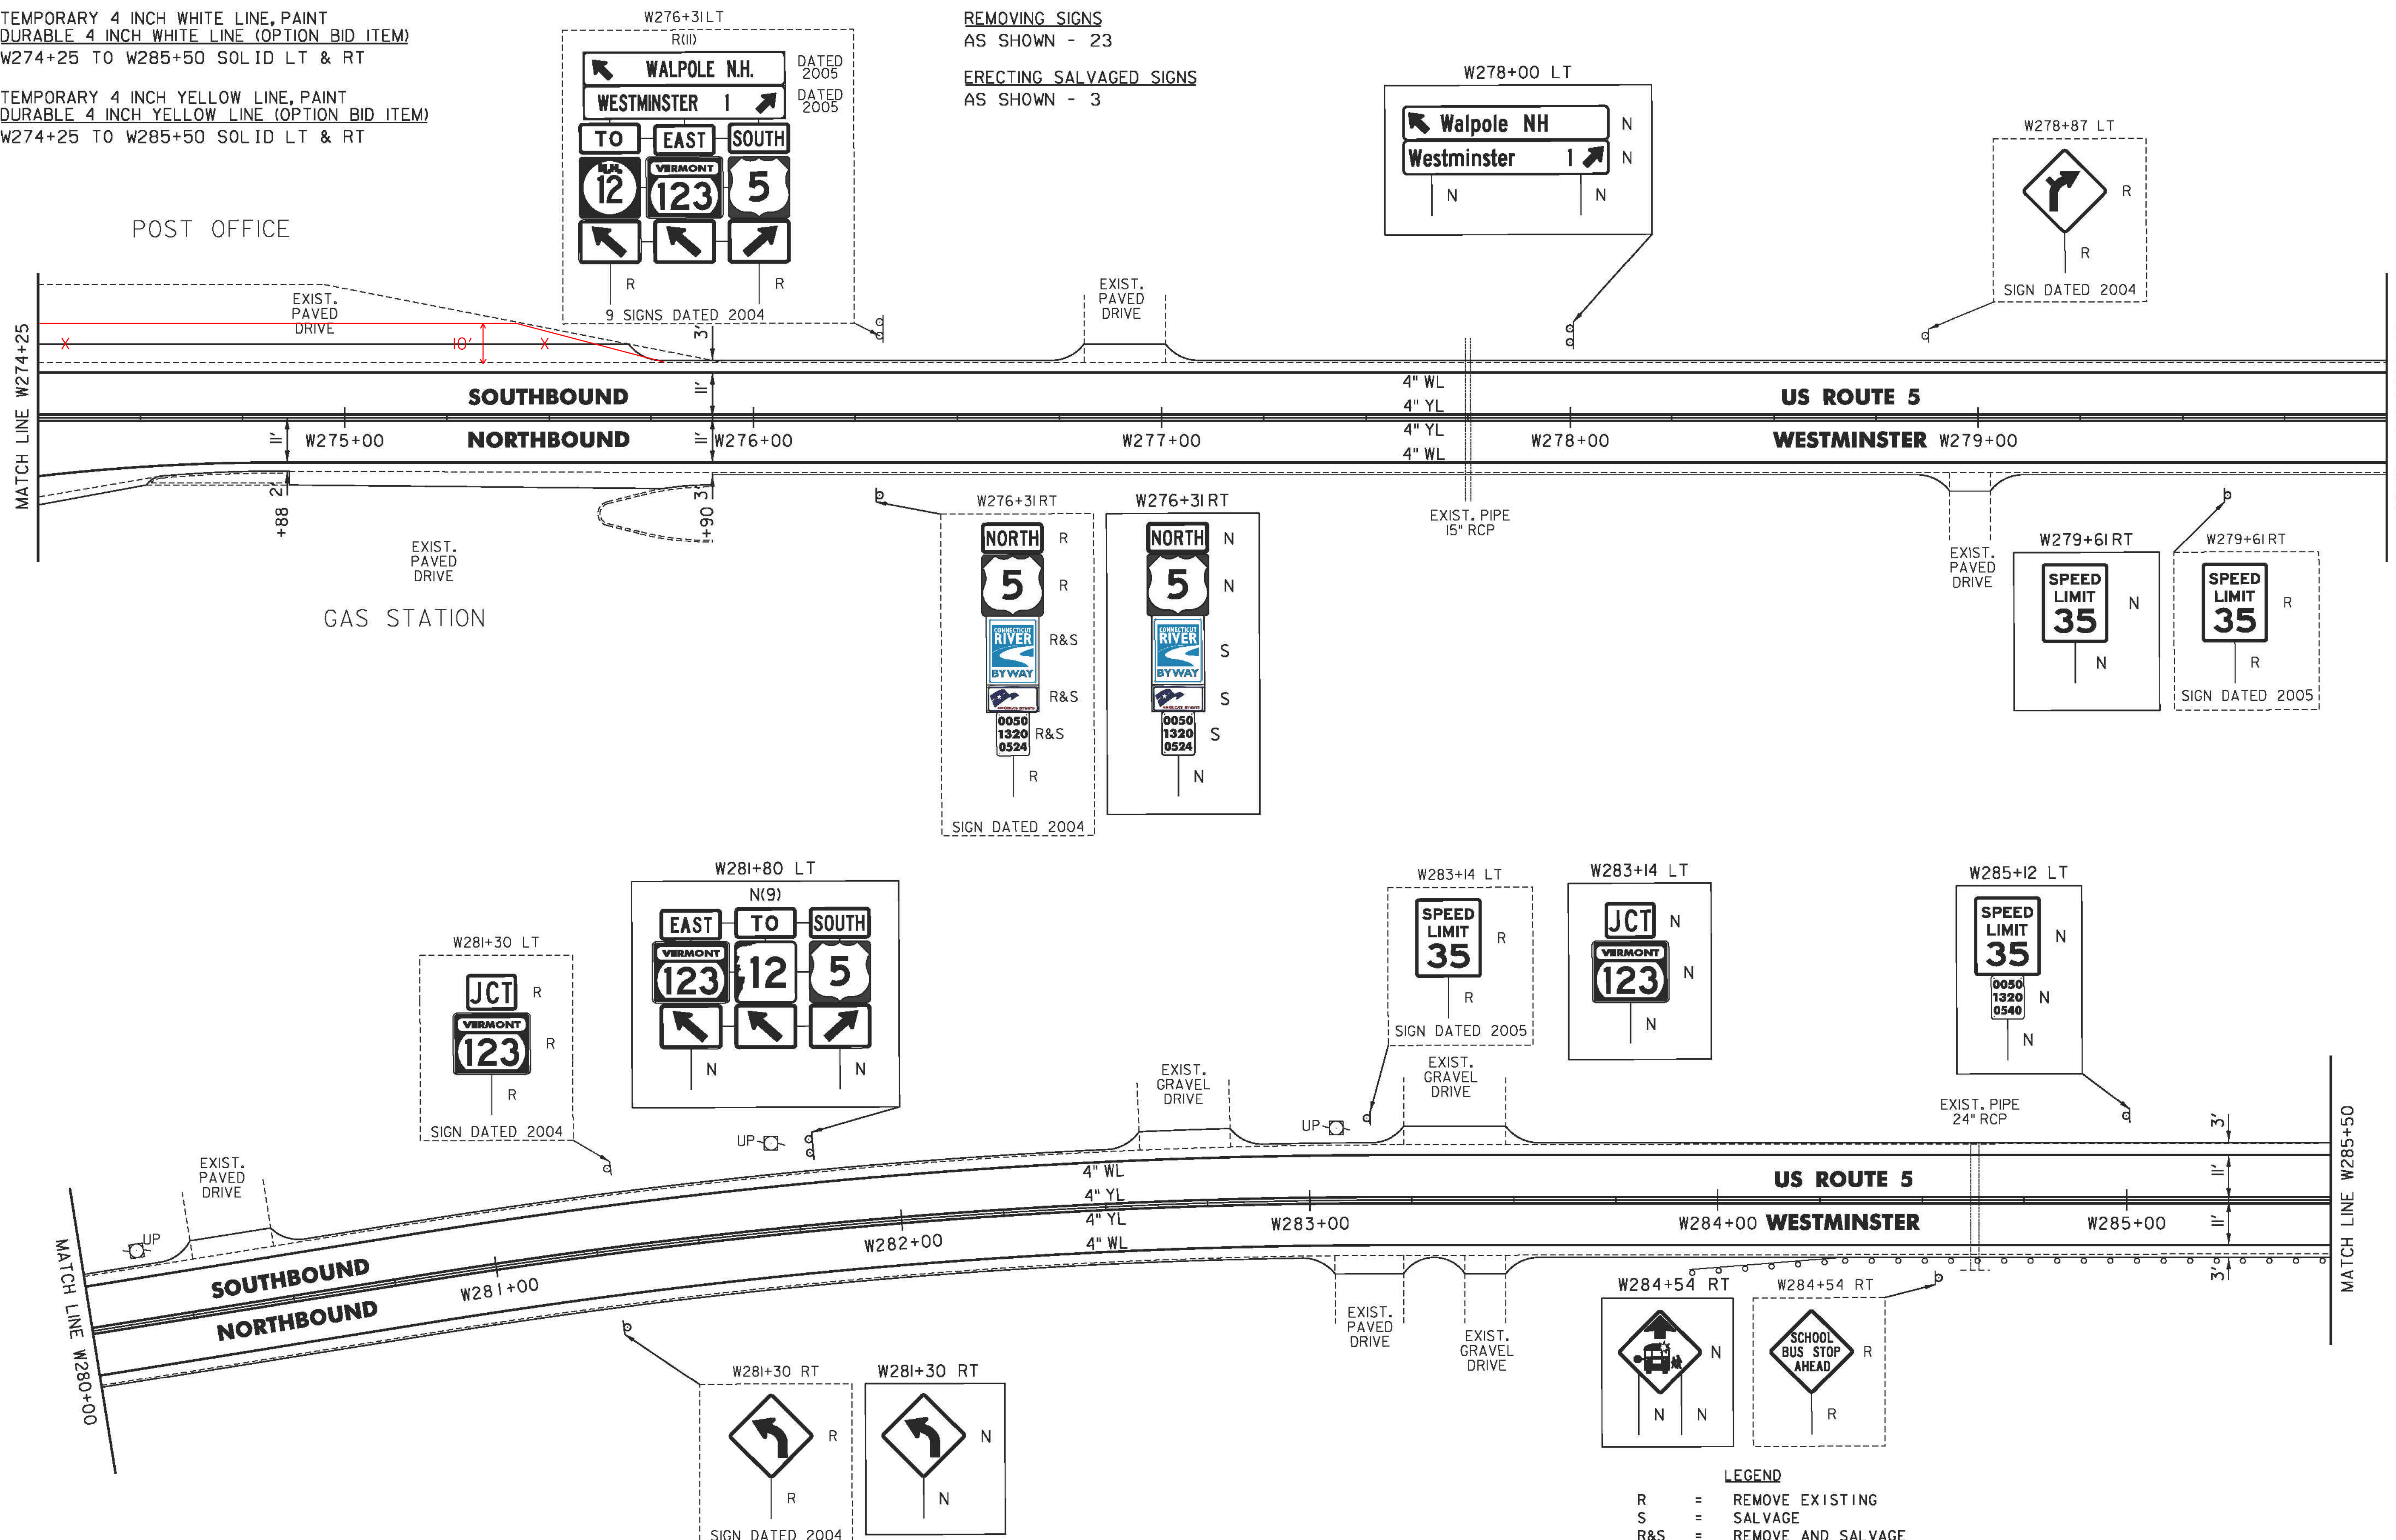

**LEGEND**

R	= REMOVE EXISTING
S	= SALVAGE
R&S	= REMOVE AND SALVAGE
N	= NEW
RET	= RETAIN
B-B	= BACK TO BACK
---	= EXISTING GUARDRAIL
- - -	= PROPOSED GUARDRAIL
YL	= YELLOW LINE
WL	= WHITE LINE
⊙	= DELINEATOR
⊕	= UTILITY POLE

PROJECT NAME:	PUTNEY-WESTMINSTER
PROJECT NUMBER:	STP 2946(I)
FILE NAME:	zllc344bdr.dgn
PROJECT LEADER:	P. SHEDD
DESIGNED BY:	N. LEMAY
ROADWAY LAYOUT:	62 US 5
PLOT DATE:	12/10/2013
DRAWN BY:	W. GORDON
CHECKED BY:	P. SHEDD
SHEET:	83 OF 138

NOT TO SCALE