STATE OF VERMONT
AGENCY OF TRANSPORTATION

TRAFFIC SIGN SUMMARY SHEET 11

MILEMARKER, STATION, OR SIGN NUMBER	SIGN LEGEND	SIGN DIMENSIONS EA	WIDTH (in)	HEIGHT (in)	NEW & SALVAGED SIGNS "A"	"B"	SALV SIGN	SALV TIS	EXIST POST RETAIN	SALVAGE	NEW SIGN POSTS NO. OF POSTS	FLANGED CHANNEL lb/ft 1.12	2.0	3.0	SQUARE STEEL (in) lb/ft 1.75	2.0	2.5	ANCHOR	SLEEVE	TUBULAR ALUMINUM Ø (in) lb/ft 3.0	4.0	4.0 MOD	TUBULAR STEEL Ø (in) FOUND-ATION	lb/ft 3.0	3.5	4.0	5.0	W-SHAPE STEEL FTG. SIZE 24"	30"	WEIGHT	POST SIZE	SIGN FRAME REQUIRED	REMARKS	SIGN DETAIL DETAIL IN SHSM * BOOK	DETAIL ON SHEET NUMBER	STD. SHEET NUMBER
WILLISTON U.S. ROUTE 2 (CONT.)																																				
62+64, RT		1	6	10	✓ 0.42						1				9.25 X ✓			X															VD-701			T-42
62+85, LT		1	6	10	✓ 0.42						1				9.25 X ✓			X															VD-701			T-42
63+57, LT		1	6	10	✓ 0.42																												VD-700 MOUNT NEW MM PLAQUE BELOW EXISTING TIS SIGNS ON EXISTING POST ✓			T-44
65+25, RT		1 1	21 24	15 24	✓ 2.19 ✓ 4.00						1					13.75 X ✓		X															M2-1 (GREEN ON WHITE) (GREEN ON WHITE)			E-136B E-136B
66+05, LT		1 1 1	24 24 24	30 24 12	✓ 5.00 ✓ 2.00 ✓ 2.50						1						16.00 X ✓	X															R2-1 R8-3 M4-4 (BLACK ON WHITE)	X X X		
66+25, RT		1 1	24 24	24 12	✓ 4.00 ✓ 2.00						1					14.25 X ✓		X															R8-3 M4-14 (BLACK ON WHITE)	X X		
67+40, RT		1	30	30	✓ 6.25						1					14.00 X ✓		X															VR-921			E-145A
68+25 RT ~~68+22, RT~~	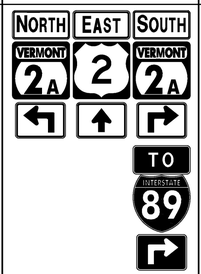	1 1 1 1 1 1 1 1 1 1 1 1	24 24 24 24 24 24 21 21 21 24 24 21	12 12 12 24 24 24 15 15 15 12 24 15	2.00 ✓ 2.00 ✓ 2.00 ✓ 4.00 ✓ 4.00 ✓ 4.00 ✓ 2.19 ✓ 2.19 ✓ 2.19 ✓ 2.00 ✓ 4.00 ✓ 2.19 ✓						2 ✓																				2 ✓	258.40 X ✓				*3A	M3-1 (GREEN ON WHITE) M3-2 (BLACK ON WHITE) M3-3 (GREEN ON WHITE) (GREEN ON WHITE) MI-4 (GREEN ON WHITE) FOR SIGN FRAME DETAIL SEE VTRANS STANDARD T-92 M5-1 (GREEN ON WHITE) M6-3 (BLACK ON WHITE) M5-1 (GREEN ON WHITE) M4-5 (WHITE ON BLUE) MI-1 M5-1 (WHITE ON BLUE)	X X X X X X X X		 E-136B E-136B E-136B E-136B
TOTALS					SF ✓ 61.96	SF	EA.	EA.				FT	FT	FT	FT 18.50 ~~20~~	FT 42.00 ~~46~~	FT 16.00 ~~17~~		EA	LB	LB	LB		LB 258.4 ~~291~~	LB	LB	LB								
												FT			FT 83 ~~76.50~~					LB			EA. 2	LB 291 ~~258.4~~				EA.	EA.	LB					

* "SHSM"-STANDARD HIGHWAY SIGNS AND MARKINGS BOOK

FINAL POST LENGTHS ARE TO BE DETERMINED IN THE FIELD. POST SIZES ARE COMPUTED BASED ON INFORMATION FURNISHED ON THE STANDARD SHEETS AND THE VAOT "SIGN POST DESIGN GUIDELINE."

PROJECT NAME: SOUTH BURLINGTON-WILLISTON
PROJECT NUMBER: NH 2944(I)

FILE NAME: z11d340frm.dgn
PROJECT LEADER: G. EDWARDS
DESIGNED BY: D. DRAPER
TRAFFIC SIGN SUMMARY SHEET II

PLOT DATE: 2/15/2017
DRAWN BY: D. DRAPER
CHECKED BY: J. LITTLE
SHEET 103 OF 249