STATE OF VERMONT
AGENCY OF TRANSPORTATION

TRAFFIC SIGN SUMMARY SHEET 02

MILEMARKER, STATION, OR SIGN NUMBER	SIGN LEGEND	SIGN DIMENSIONS EA	WIDTH (in)	HEIGHT (in)	NEW & SALVAGED SIGNS "A"	"B"	SALV SIGN	SALV TIS	EXIST POST RETAIN	SALVAGE	NO. OF POSTS	FLANGED CHANNEL lb/ft 1.12	2.0	3.0	SQUARE STEEL (in) lb/ft 1.88	1.75	2.0	2.5	ANCHOR	SLEEVE	TUBULAR ALUMINUM Ø (in) lb/ft 1.3	3.0	4.0	4.0 MOD	TUBULAR STEEL Ø (in) FOUND-ATION	3.0	3.5	4.0	5.0	W-SHAPE STEEL FTG. SIZE 24"	30"	WEIGHT	POST SIZE	SIGN FRAME REQUIRED	REMARKS	SIGN DETAIL DETAIL IN SHSM * BOOK	DETAIL ON SHEET NUMBER	STD. SHEET NUMBER
VT ROUTE 2A (CONT.)																																						
I75+46, RT		1	9	15	0.94																													RIO-3e MOUNT NEW SIGN ON EXISTING PEDESTRIAN SIGNAL POLE USING NEW MOUNTING HARDWARE (INCIDENTAL TO SIGN)	X		
I75+47, RT		1	9	15	0.94																													RIO-3e MOUNT NEW SIGN ON EXISTING PEDESTRIAN SIGNAL POLE USING NEW MOUNTING HARDWARE (INCIDENTAL TO SIGN)	X		
I76+29, LT		1 1 1	24 18 18	30 18 18	5.00 2.25 2.25						1						13.00 X		X																R4-7 OMI-1 OMI-1	X X X		
I76+66, LT	0021 0417 0333	1	6	10	0.42																													VD-700 MOUNT ON EXISTING POST BELOW EXISTING STREET SIGN			T-44
I76+69, RT	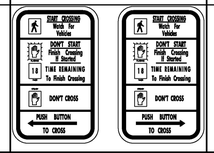	1 1	9 9	15 15	0.94 0.94																													RIO-3e MOUNT NEW SIGNS 90 DEGREES TO EACH OTHER ON EXISTING PEDESTRIAN SIGNAL POLE USING NEW MOUNTING HARDWARE (INCIDENTAL TO SIGN) RIO-3e	X X		
I76+77, LT		1	9	15	0.94																													RIO-3e MOUNT NEW SIGN ON EXISTING SIGNAL POLE USING NEW MOUNTING HARDWARE (INCIDENTAL TO SIGN)	X		
I86+67, LT	Wright Ave	1	42	12	4.00						1						11.25 X		X															D3-1		240	
I87+29, LT		1	9	15	0.94																													RIO-3e MOUNT NEW SIGN ON EXISTING PEDESTRIAN SIGNAL POLE USING NEW MOUNTING HARDWARE (INCIDENTAL TO SIGN)	X		
				TOTALS	SF 19.56	SF	EA.	EA.				FT	FT	FT	FT	FT 24.25 ~~26~~	FT		EA	LB	LB	LB		LB	LB	LB	LB										
												FT			FT ~~26~~ 24.25					LB				EA.	LB				EA.	EA.	LB					

*
"SHSM"-STANDARD HIGHWAY SIGNS AND MARKINGS

FINAL POST LENGTHS ARE TO BE DETERMINED IN THE FIELD. POST SIZES ARE COMPUTED BASED ON INFORMATION FURNISHED ON THE STANDARD SHEETS AND THE VTRANS "SIGN POST DESIGN GUIDELINE."

PROJECT NAME: WILLISTON
PROJECT NUMBER: NH 2949(1)

FILE NAME: z12d224frm.dgn
PROJECT LEADER: G. EDWARDS
DESIGNED BY: D. BARNES
TRAFFIC SIGN SUMMARY SHEET 2

PLOT DATE: 2/15/2017
DRAWN BY: D. BARNES
CHECKED BY: J. LITTLE
SHEET 236 OF 249