STATE OF VERMONT
AGENCY OF TRANSPORTATION

TRAFFIC SIGN SUMMARY SHEET 05

MILEMARKER, STATION, OR SIGN NUMBER	SIGN LEGEND	SIGN DIMENSIONS EA	SIGN DIMENSIONS WIDTH (in)	SIGN DIMENSIONS HEIGHT (in)	NEW & SALVAGED SIGNS "A"	NEW & SALVAGED SIGNS "B"	NEW & SALVAGED SIGNS SALV SIGN	NEW & SALVAGED SIGNS SALV TIS	EXIST POST RETAIN	EXIST POST SALVAGE	NEW SIGN POSTS NO. OF POSTS	FLANGED CHANNEL lb/ft 1.12	FLANGED CHANNEL lb/ft 2.0	FLANGED CHANNEL lb/ft 3.0	SQUARE STEEL (in) lb/ft 1.75	SQUARE STEEL (in) lb/ft 2.0	SQUARE STEEL (in) lb/ft 2.5	ANCHOR	SLEEVE	TUBULAR ALUMINUM Ø (in) lb/ft 3.0	TUBULAR ALUMINUM Ø (in) lb/ft 4.0	TUBULAR ALUMINUM Ø (in) lb/ft 4.0 MOD	FOUND-ATION	TUBULAR STEEL Ø (in) lb/ft 3.0	TUBULAR STEEL Ø (in) lb/ft 3.5	TUBULAR STEEL Ø (in) lb/ft 4.0	TUBULAR STEEL Ø (in) lb/ft 5.0	W-SHAPE STEEL FTG. SIZE 24"	W-SHAPE STEEL FTG. SIZE 30"	W-SHAPE STEEL WEIGHT	W-SHAPE STEEL POST SIZE	SIGN FRAME REQUIRED	REMARKS	SIGN DETAIL DETAIL IN SHSM * BOOK	SIGN DETAIL DETAIL ON SHEET NUMBER	SIGN DETAIL STD. SHEET NUMBER
VT ROUTE 2A (CONT.)																																				
197+14, LT		1	18	18	✓ 2.25						1					9.25 X ✓		X																OMI-1	X		
197+15, RT		1	9	15	✓ 0.94																													RIO-3e MOUNT NEW SIGN ON EXISTING PEDESTRIAN SIGNAL POLE USING NEW MOUNTING HARDWARE (INCIDENTAL TO SIGN)	X		
197+20, LT		1	9	15	✓ 0.94																													RIO-3e MOUNT NEW SIGN ON EXISTING PEDESTRIAN SIGNAL POLE USING NEW MOUNTING HARDWARE (INCIDENTAL TO SIGN)	X		
197+47, LT		1	9	15	✓ 0.94																													RIO-3e MOUNT NEW SIGN ON EXISTING PEDESTRIAN SIGNAL POLE USING NEW MOUNTING HARDWARE (INCIDENTAL TO SIGN)	X		
201+56, LT		1 1	48 6	30 10	✓ 10.00 ✓ 0.42						✓ 2					✓ 14.75 X 14.00 ✓		X																VR-934 VD-700			E-145B T-44
203+25, LT	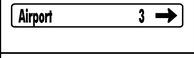		72	12	✓ 6.00				✓ 2																									VD2-1 MOUNT NEW SIGN ON EXISTING POST, REPLACING EXISTING "AIRPORT" DESTINATION BOARD			T-93
	SHEET 235 SUBTOTALS				47.3 ✓		1								58.75 ~~92~~	28.75																				
	SHEET 236 SUBTOTALS				19.56 ✓										24.25 ~~26~~																					
	SHEET 237 SUBTOTALS				34.51		1								85.75 ~~85~~																					
	SHEET 238 SUBTOTALS				39.2										18.75 ~~19~~																					
	SHEET 239 SUBTOTALS				21.49 ✓										38.00 ~~42~~																					
	PROJECT SUBTOTALS				162.06		2								254.25 ~~264~~																					
	ROUNDING				0.94		-								+																					
												FT	FT	FT	FT	FT 225.50 ~~265~~	FT 28.75		EA	LB	LB	LB		LB	LB	LB	LB								
	TOTALS				SF 163	SF	EA. 2	EA.				FT			FT ~~265~~ 254.25					LB			EA.	LB				EA.	EA.	LB					

* "SHSM"-STANDARD HIGHWAY SIGNS AND MARKINGS

FINAL POST LENGTHS ARE TO BE DETERMINED IN THE FIELD. POST SIZES ARE COMPUTED BASED ON INFORMATION FURNISHED ON THE STANDARD SHEETS AND THE VTRANS "SIGN POST DESIGN GUIDELINE."

PROJECT NAME: WILLISTON
PROJECT NUMBER: NH 2949(1)

FILE NAME: z12d224frm.dgn
PROJECT LEADER: G. EDWARDS
DESIGNED BY: D. BARNES
TRAFFIC SIGN SUMMARY SHEET 5

PLOT DATE: 2/15/2017
DRAWN BY: D. BARNES
CHECKED BY: J. LITTLE
SHEET 239 OF 249