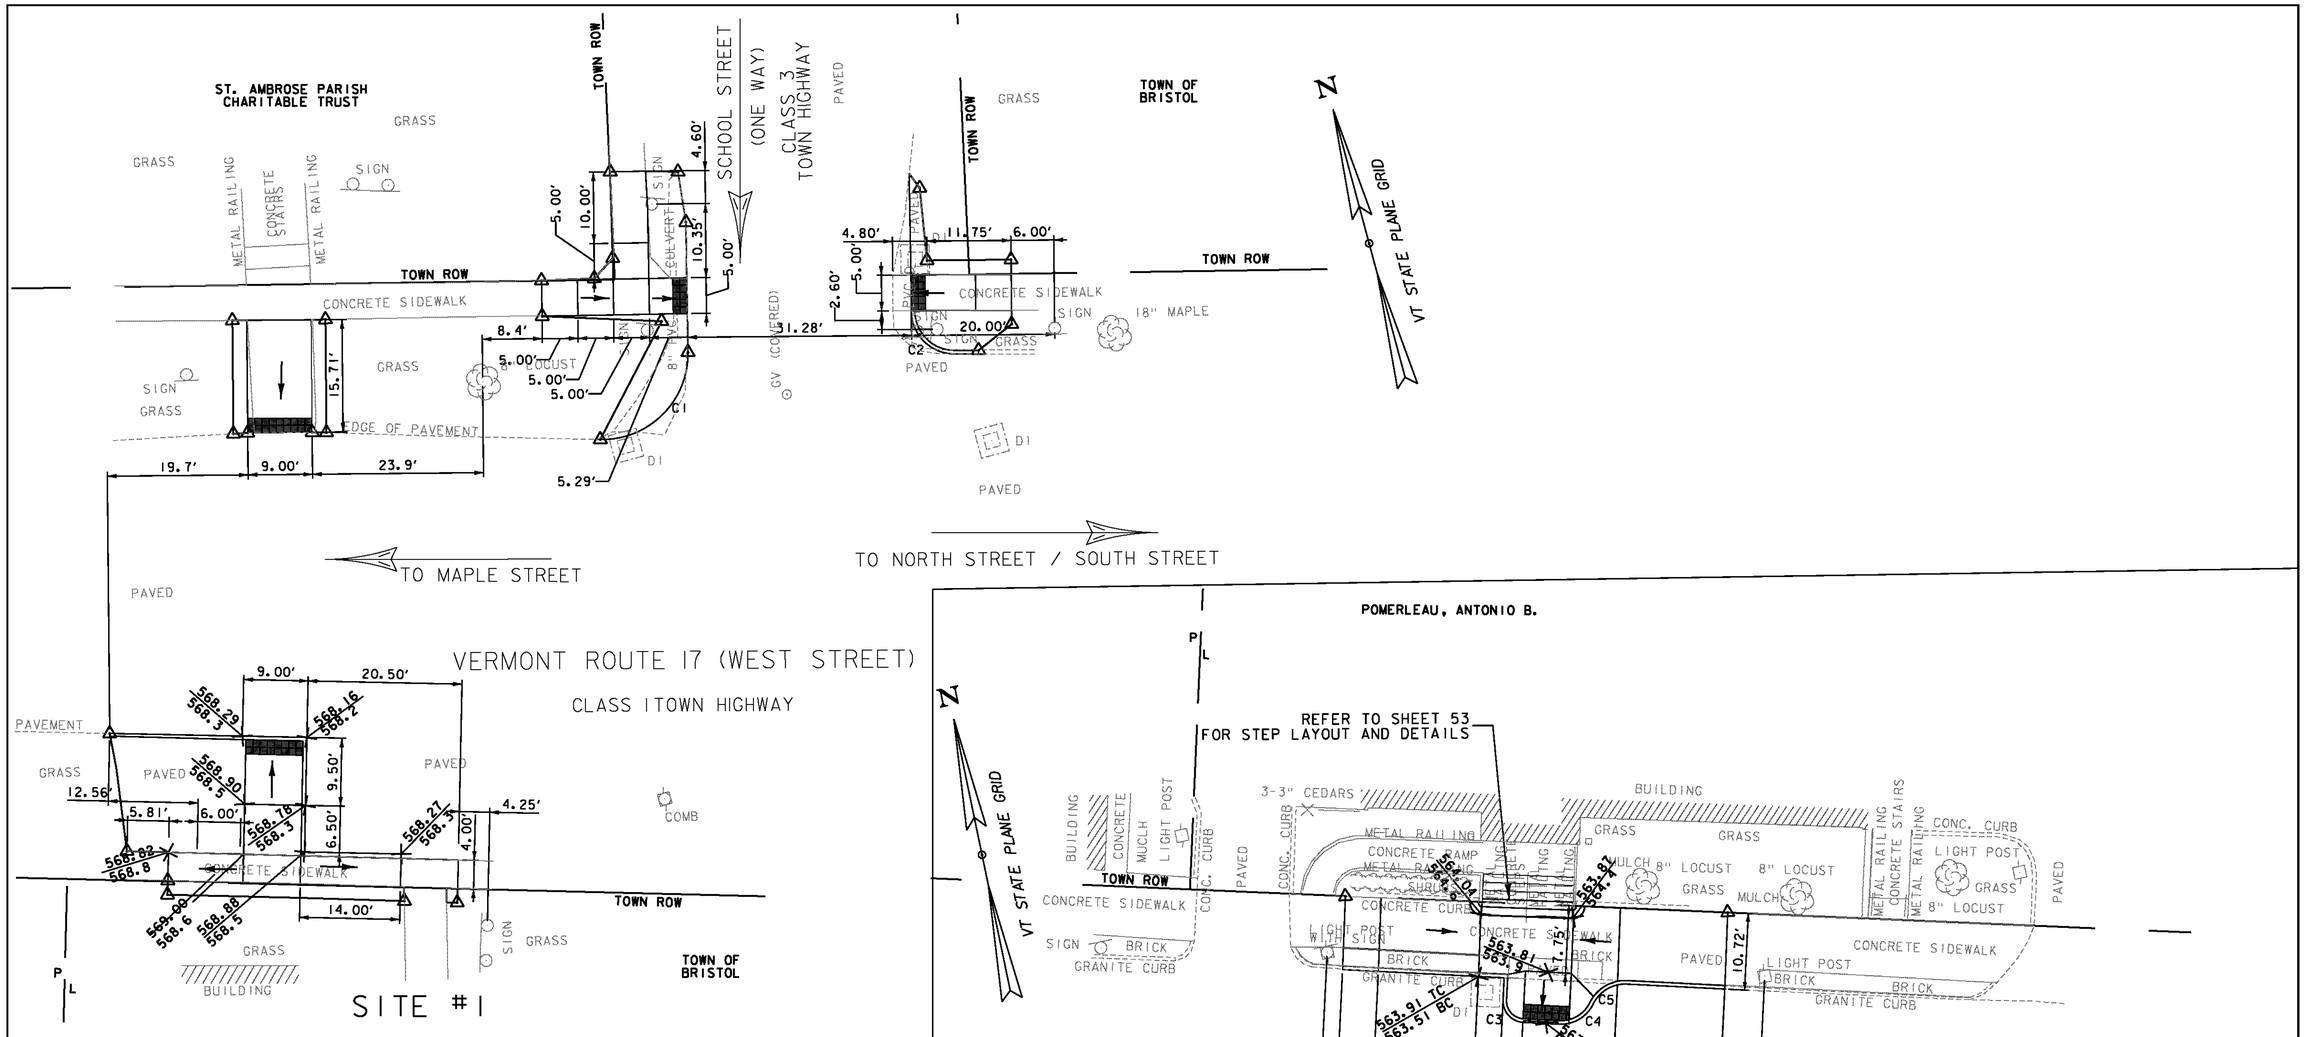

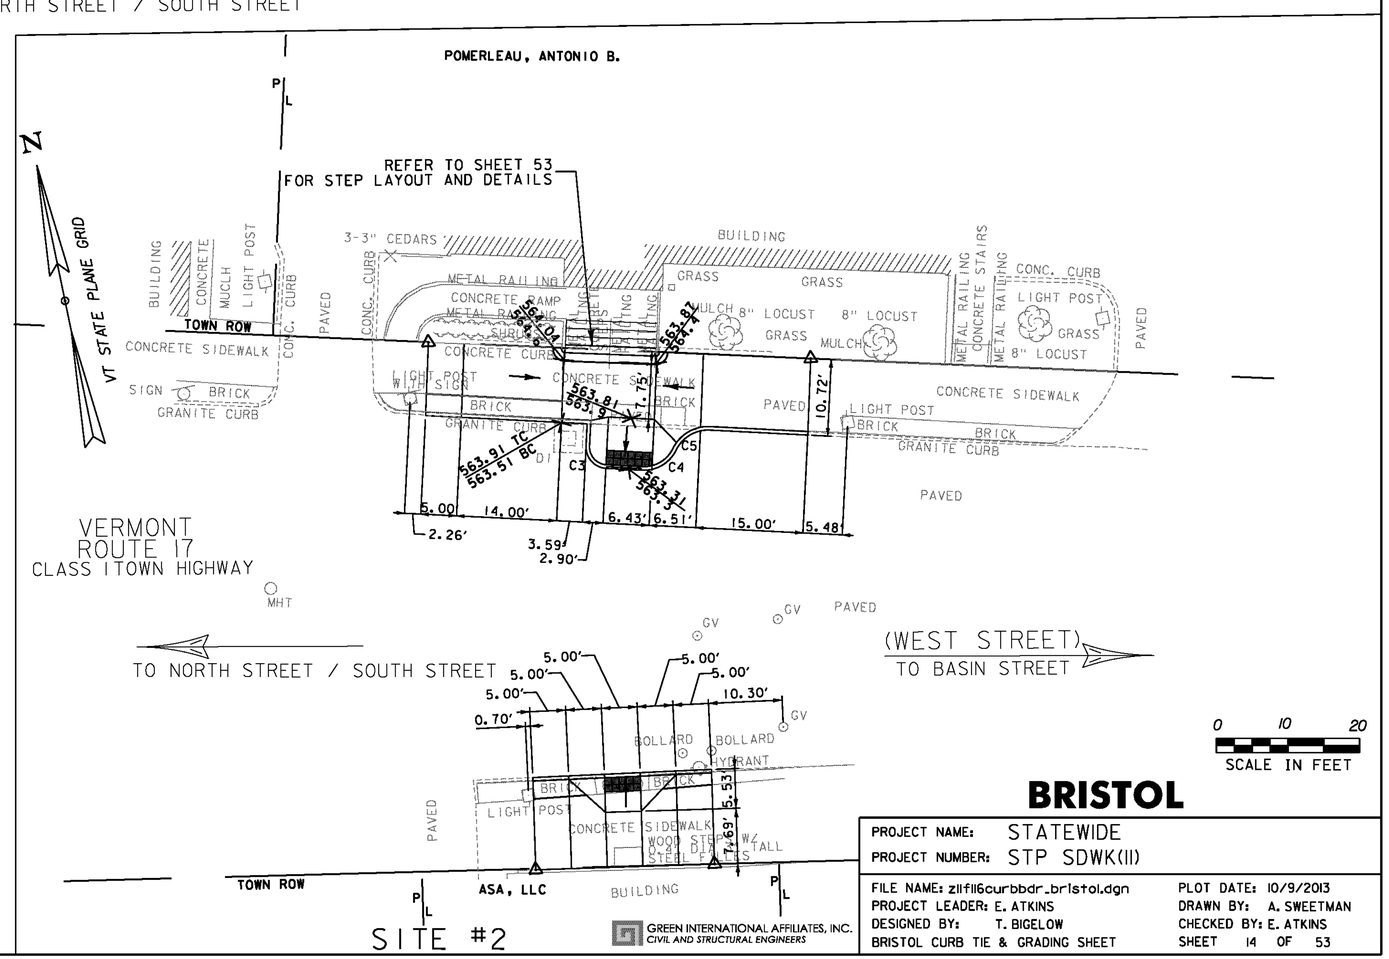

CURVE TABLE

LABEL	RADIUS (ft)	LENGTH (ft)
C1	12.00	19.28
C2	6.00	9.36
C3	3.00	4.71
C4	5.00	5.84
C5	5.00	5.84

0 10 20
SCALE IN FEET

BRISTOL

PROJECT NAME: STATEWIDE
PROJECT NUMBER: STP SDWK(11)

FILE NAME: z11f116curbbdr_bristol.dgn
PROJECT LEADER: E. ATKINS
DESIGNED BY: T. BIGELOW
BRISTOL CURB TIE & GRADING SHEET

PLOT DATE: 10/9/2013
DRAWN BY: A. SWEETMAN
CHECKED BY: E. ATKINS
SHEET 14 OF 53

GREEN INTERNATIONAL AFFILIATES, INC.
CIVIL AND STRUCTURAL ENGINEERS