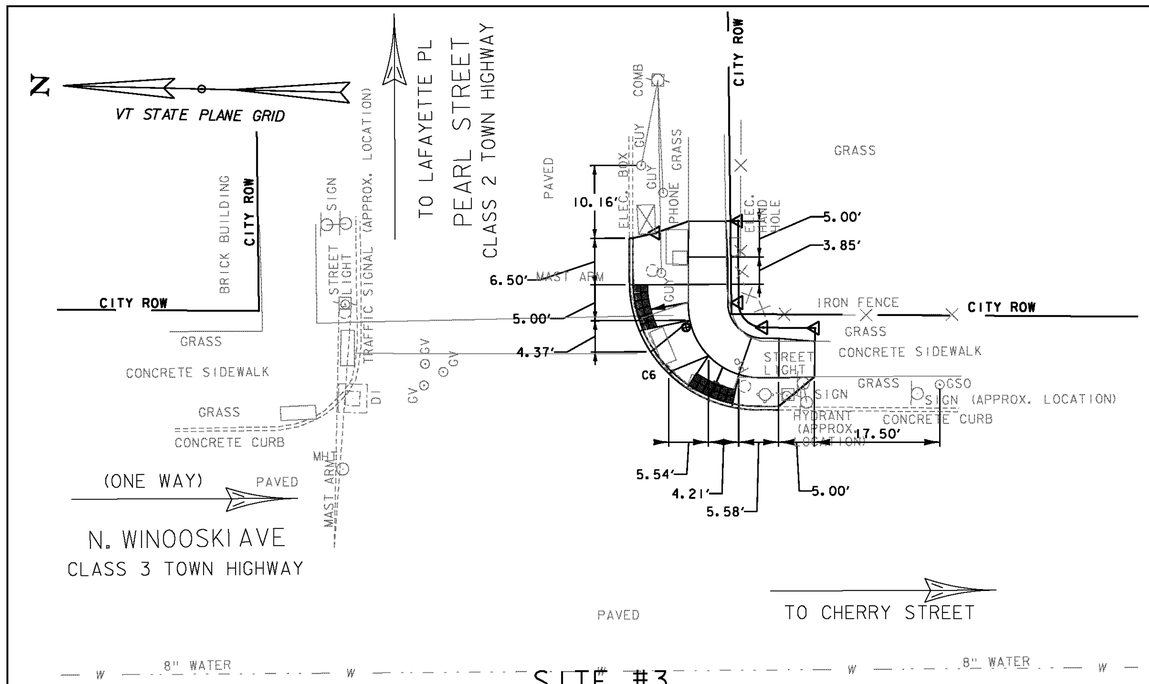

SITE #3

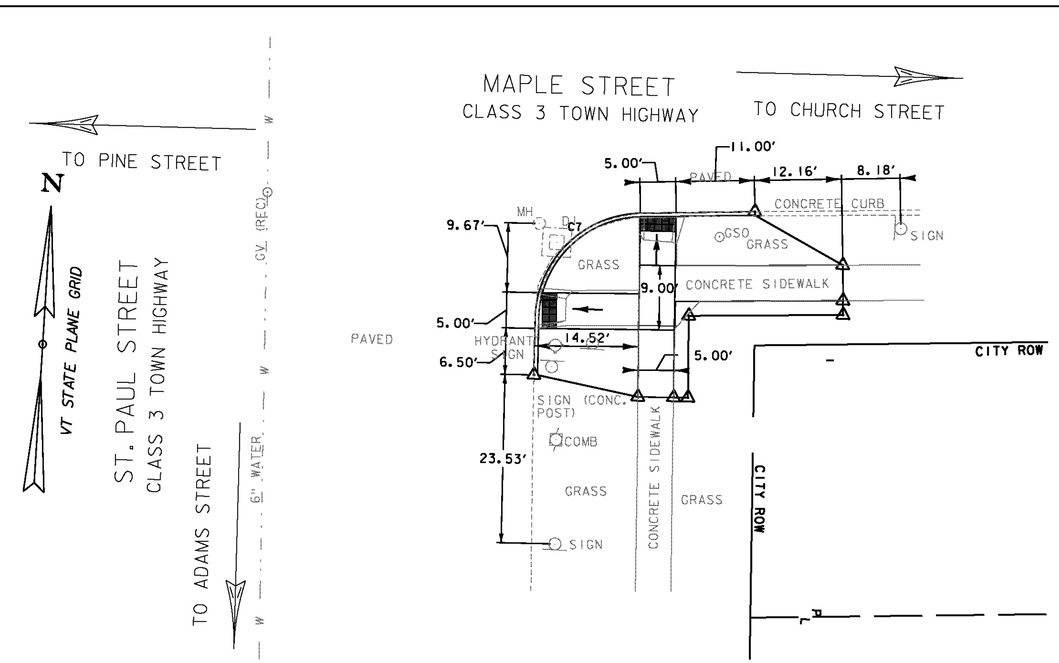

SITE #4

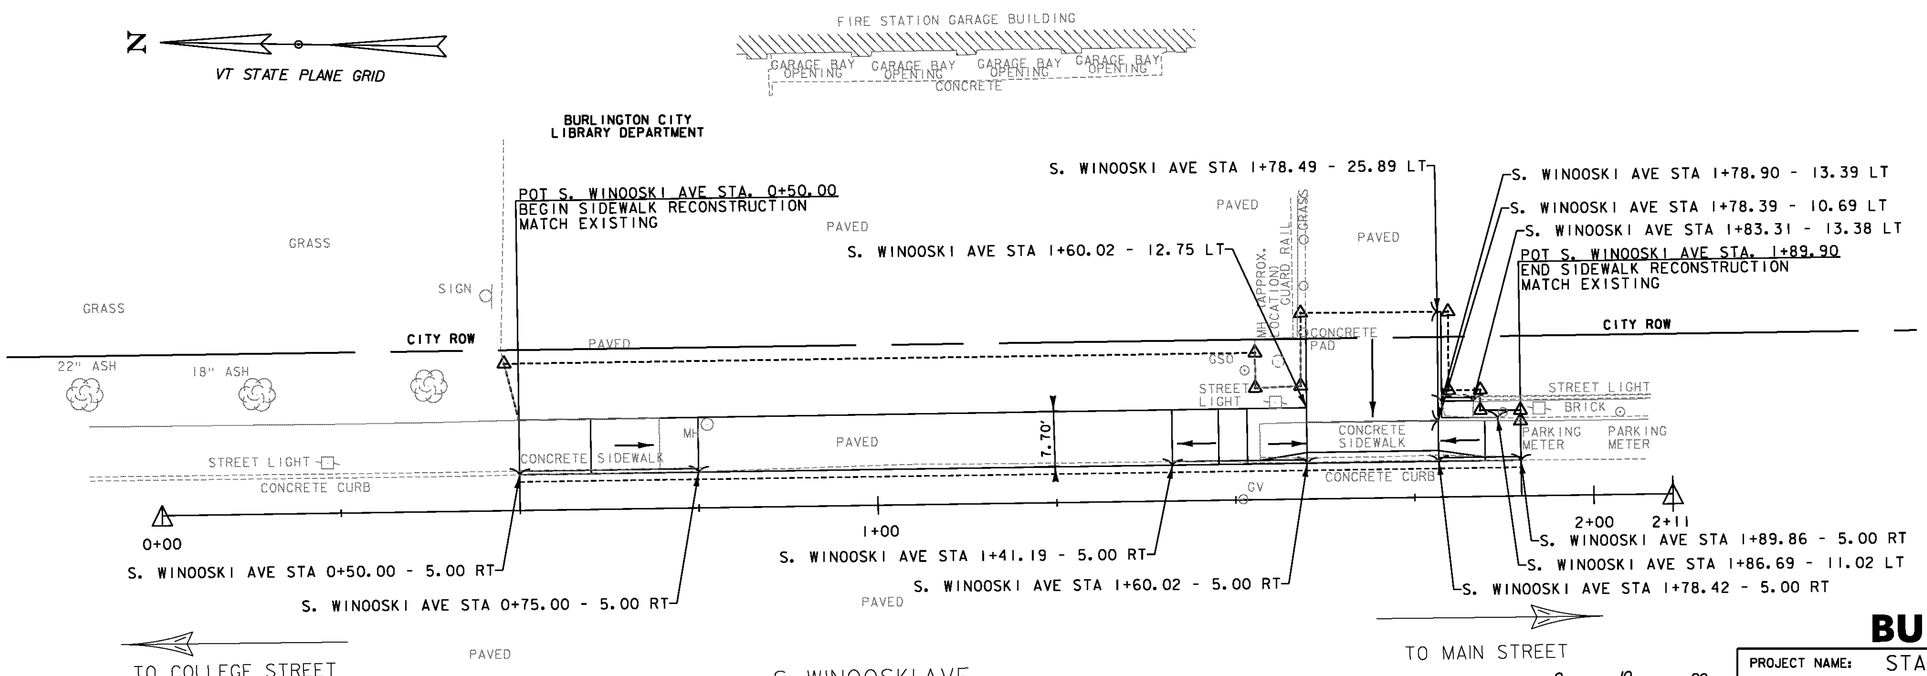

S. WINOOSKI AVE

CLASS I TOWN HIGHWAY

SITE #5

CURVE TABLE

LABEL	RADIUS (ft)	LENGTH (ft)
C6	18.00	28.02
C7	15.00	23.75

GREEN INTERNATIONAL AFFILIATES, INC.
CIVIL AND STRUCTURAL ENGINEERS

BURLINGTON

PROJECT NAME: STATEWIDE
PROJECT NUMBER: STP SDWK(11)

FILE NAME: z11f116curbbdr_burlington.dgn
PROJECT LEADER: E. ATKINS
DESIGNED BY: T. BIGELOW
BURLINGTON CURB TIE & GRADING SHEET 2

PLOT DATE: 10/9/2013
DRAWN BY: A. SWEETMAN
CHECKED BY: E. ATKINS
SHEET 20 OF 53