DIRECTION	MILEPOINT	LOCATION CODE (SHEET 2)	SIGN CODE	WIDTH (IN)	HEIGHT (IN)	SHEETING REMARKS	SIGN LEGEND	NEW SIGNS "A"	NEW SIGNS "B"	EXISTING SIGNS RETAIN	EXISTING SIGNS SALVAGE FROM	EXISTING SIGNS SALVAGE TO	EXISTING SIGNS REMOVE	EXIST POST RETAIN	EXIST POST REMOVE	NUMBER OF NEW POSTS	SQUARE STEEL (IN) 1.75 (LB / FT) 1.88	SQUARE STEEL (IN) 2.00 (LB / FT) 2.42	SQUARE STEEL (IN) 2.50 (LB / FT) 3.35	TUBULAR STEEL Ø (IN) FOUNDATION	TUBULAR STEEL Ø (IN) 3.00 (LB / FT) 7.60	TUBULAR STEEL Ø (IN) 3.50 (LB / FT) 9.00	TUBULAR STEEL Ø (IN) 4.00 (LB / FT) 10.80	TUBULAR STEEL Ø (IN) 5.00 (LB / FT) 14.60	SIGN FRAME REQUIRED	REMARKS	SIGN DETAIL LOCATION SHSM	SIGN DETAIL LOCATION PROJECT SHEET #	SIGN DETAIL LOCATION STANDARD SHEET #
BARTON US-5 NB							FY-FLUORESCENT YELLOW FYG-FLUORESCENT YELLOW GREEN																				"SHSM"-STANDARD HIGHWAY SIGNS AND MARKINGS			
NB	0.000	C	VD-024	60	7.5		BARTON/SUTTON					I	1		X														
		C	VD-025	60	7.5		ORLEANS CO/CALEDONIA CO						1																
		C	VD-024	72	10		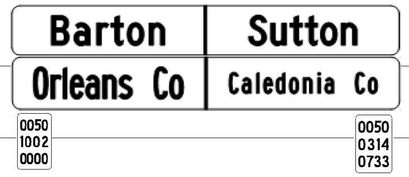	5.00								2		9'-10" X								6	
		C	VD-025	72	10			5.00																				6	
		C	VD-700	6	10			0.42																					T-44
		C	VD-700	6	10			0.42																					T-44
NB	0.716	A/B	D3-1	UNK.	UNK.		WHEELER MTN RD (TH-56)					1				2		8'-9" X								WHEELER MOUNTAIN RD (TH-56); SALVAGE FROM EXISTING LOCATION; INSTALL 8 FT FROM EDGE OF PAVEMENT			
NB	0.717	C	VR-017	24	30		LLL 24,000 LBS						1		X														
		C	VR-017	24	30											1		9'-7" X								WHEELER MOUNTAIN RD (TH-56)		9	
NB	0.723	D	R1-1	30	30		STOP						1		X														
		D	R1-1	30	30			6.25								1		9'-6" X								WHEELER MOUNTAIN RD (TH-56)	X		
NB	0.726	A/B	D3-1	UNK.	UNK.		WHEELER MTN RD (TH-56)				1		1		X														
		A/B	D3-1	40	12			3.33								2		7'-7" X								WHEELER MOUNTAIN RD (TH-56)		11	
NB	1.293	A	M1-4	18	18		US 5						1		X														
NB	1.544	C	VR-017	24	30		LLL 24,000 LBS			1				X													LACLAIR LN (TH-66)			
SIGN SUMMARY SHEET							SHEET TOTALS	20.42	0.00	1	1	1	6	0	0	8		120.0		0	0.0	0.0	0.0	0.0				
								SF	SF	EA	EA	EA	EA	EA	EA	EA		FT		EA	LB	LB	LB	LB				
VERMONT AGENCY OF TRANSPORTATION							TOWN DIRECTIONAL TOTALS	294.6	0.0	55	4	3	70	0	0	50		750.0		0	0.0							

PROJECT NAME: **BARTON-DERBY**
PROJECT NUMBER: **STPG SIGN(46)**

FILE NAME: **01 BARTON US 5 NB TSS.xls** PLOT DATE: **11/7/2014**
PROJECT MANAGER: **D. BRYANT** DRAWN BY: **J. BLANCHARD**
DESIGNED BY: **B. TOOTHAKER** CHECKED **K. KERN**
BARTON NB SHEET 1 SHEET **14** OF **100**