DIRECTION	MILEPOINT	LOCATION CODE (SHEET 2)	SIGN CODE	WIDTH (IN)	HEIGHT (IN)	SHEETING REMARKS	SIGN LEGEND	NEW SIGNS "A"	NEW SIGNS "B"	EXISTING SIGNS RETAIN	EXISTING SIGNS SALVAGE FROM	EXISTING SIGNS SALVAGE TO	EXISTING SIGNS REMOVE	EXIST POST RETAIN	EXIST POST REMOVE	NUMBER OF NEW POSTS	SQUARE STEEL (IN) 1.75 (LB / FT) 1.88	SQUARE STEEL (IN) 2.00 (LB / FT) 2.42	SQUARE STEEL (IN) 2.50 (LB / FT) 3.35	TUBULAR STEEL Ø (IN) FOUNDATION	TUBULAR STEEL Ø (IN) 3.00 (LB / FT) 7.60	TUBULAR STEEL Ø (IN) 3.50 (LB / FT) 9.00	TUBULAR STEEL Ø (IN) 4.00 (LB / FT) 10.80	TUBULAR STEEL Ø (IN) 5.00 (LB / FT) 14.60	SIGN FRAME REQUIRED	REMARKS	SIGN DETAIL LOCATION SHSM	SIGN DETAIL LOCATION PROJECT SHEET #	SIGN DETAIL LOCATION STANDARD SHEET #
COVENTRY US-5 SB							FY-FLUORESCENT YELLOW FYG-FLUORESCENT YELLOW GREEN																				"SHSM"-STANDARD HIGHWAY SIGNS AND MARKINGS			
SB	1.263	F	VW-054R	30	30		HIDDEN DRIVE RIGHT						1	X															
		F	VW-133R	30	30			6.25																			10	
SB	1.228	E/F	D3-1	UNK.	UNK.		FARBERS MILL RD (TH-38)						1		X														
		E/F	D3-1	56	12			4.67								2		X							FARBERS MILL RD (TH-38)		12	
SB	0.757	F	M2-1	21	15		JCT STATE						1		X														
		F	M1-5	24	24		VERMONT 14						1																
		F	M2-1	21	15		JCT STATE						1																
		F	M4-4	24	12		TRUCK STATE						1																
		F	M1-5	30	24		VERMONT 105						1																
		F	M2-1	21	15	GRN/ WHT		2.19								2		12'-6" X 12'-6"								1B			E-136B
		F	M1-5	24	24	GRN/ WHT	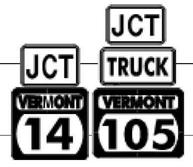	4.00																				E-136B
		F	M2-1	21	15	GRN/ WHT		2.19																				E-136B
		F	M4-4	24	12	GRN/ WHT		2.00																				E-136B
		F	M1-5A	30	24	GRN/ WHT		5.00																				E-136B
SB	0.708	F	D1-1A	72	10		^UP ORLEANS 5						1		X														
							SHEET TOTALS	26.29	0.00	0	0	0	8	0	0	4		60.0		0	0.0	0.0	0.0	0.0					
								SF	SF	EA	EA	EA	EA	EA	EA	EA		FT		EA	LB	LB	LB	LB					
							TOWN DIRECTIONAL TOTALS	265.0	0.0	0	1	0	58	0	0	29		435.0		0		0.0							

SIGN SUMMARY SHEET

VERMONT AGENCY OF TRANSPORTATION

PROJECT NAME: **BARTON-DERBY**
PROJECT NUMBER: **STPG SIGN (46)**
FILE NAME: **06 COVENTRY US 5 SB TSS.xl**
PROJECT MANAGER: **D. BRYANT**
DESIGNED BY: **B. TOOTHAKER**
PLOT DATE: **11/7/2014**
DRAWN BY: **J. BLANCHARD**
CHECKED **K. KERN**
COVENTRY SB SHEET 2
SHEET **63** OF **100**