STATE OF VERMONT
AGENCY OF TRANSPORTATION

TRAFFIC SIGN SUMMARY SHEET 6

MILE MARKER, STATION OR SIGN NUMBER	SIGN LEGEND	SIGN DIMENSIONS			NEW & SALVAGED SIGNS				EXIST POST		NEW SIGN POSTS																						REMARKS	SIGN DETAIL	
		EACH	WIDTH (in)	HEIGHT (in)	"A"	"B"	SALV SIGN	SALV TIS	RETAIN	SALVAGE	NO. OF POST	FLANGED CHANNEL (LB / FT)			SQUARE STEEL (in) (LB / FT)			ANCHOR	SLEEVE	TUBULAR ALUMINUM Ø (IN) (LB / FT)			FOUNDATION	TUBULAR STEEL Ø (IN) (LB / FT)				W-SHAPE STEEL FTG. SIZE		WEIGHT	POST SIZE	SIGN FRAME REQUIRED		DETAIL ON SHEET NUMBER	STANDARD SHEET NUMBER
															1.75	2.00	2.50			3.00	4.00	4.0 MOD		3.00	3.50	4.00	5.00	24"	30"						
												1.12	2.00	3.00	1.88	2.42	3.35			1.30	1.70	1.70		7.60	9.00	10.80	14.60								
OPTION ITEMS																																			
	DARLING RD (TH-22)																																		
10+42.00 RT		1	24.0	30.0	5.0						1.0					15.0		X															VR-017		T-70
10+47.00 RT		1	30.0	30.0	6.3						1.0					15.0		X															W11-15A		SHSM
		1	24.0	12.0	2.0																												W16-7pL		SHSM
10+58.00 LT		1	38.0	8.0	2.1						1.0					15.0		X															D3-1 (SEE "TRAIL CROSSING TYPICAL" SHEET)	9	SHSM
		1	18.0	18.0	2.3																												R1-1		SHSM
10+62.00 RT	Darling Rd	1	38.0	8.0	2.1						1.0					15.0		X															D3-1 (SEE "TRAIL CROSSING TYPICAL" SHEET)	9	SHSM
		1	18.0	18.0	2.3																												R1-1		SHSM
10+78.00 LT		1	30.0	30.0	6.3						1.0					15.0		X															W11-15a		SHSM
		1	24.0	12.0	2.0																												W16-7pL		SHSM
13+00.00 RT		1	30.0	30.0	6.3						1.0					15.0		X															W11-15a		SHSM
		1	24.0	12.0	2.0																												W16-9P		SHSM
												FT .	FT .	FT .	FT .	FT 90.	FT .	XXXXX XXXXX XXXXX XXXXX	EA .	LB .	LB .	LB .		LB .	LB .	LB .	LB .							
	TOTALS	SF 38.7	SF .	EA. .	SF .	XXXXXXXXXXX XXXXXXXXXXX XXXXXXXXXXX						FT .			FT 90.					LB .			EA.	LB .				EA. .	EA. .	LB .					

FINAL POST LENGTHS ARE TO BE DETERMINED IN THE FIELD. POST SIZES ARE COMPUTED BASED ON INFORMATION FURNISHED ON THE STANDARD SHEETS AND THE VTRANS "SIGN POST DESIGN GUIDELINE."

PROJECT NAME: MORRISTOWN
PROJECT NUMBER: BRS 0240(3)S/STP HES 030-2(28)

FILE NAME: s78f329TSS.dgn
PROJECT MANAGER: C. CARLSON
DESIGNED BY: C. BURRALL
TRAFFIC SIGN SUMMARY SHEET 6

PLOT DATE: 12-APR-2017
DRAWN BY: G. ROKES
CHECKED J. LACROIX
SHEET 73 OF 175