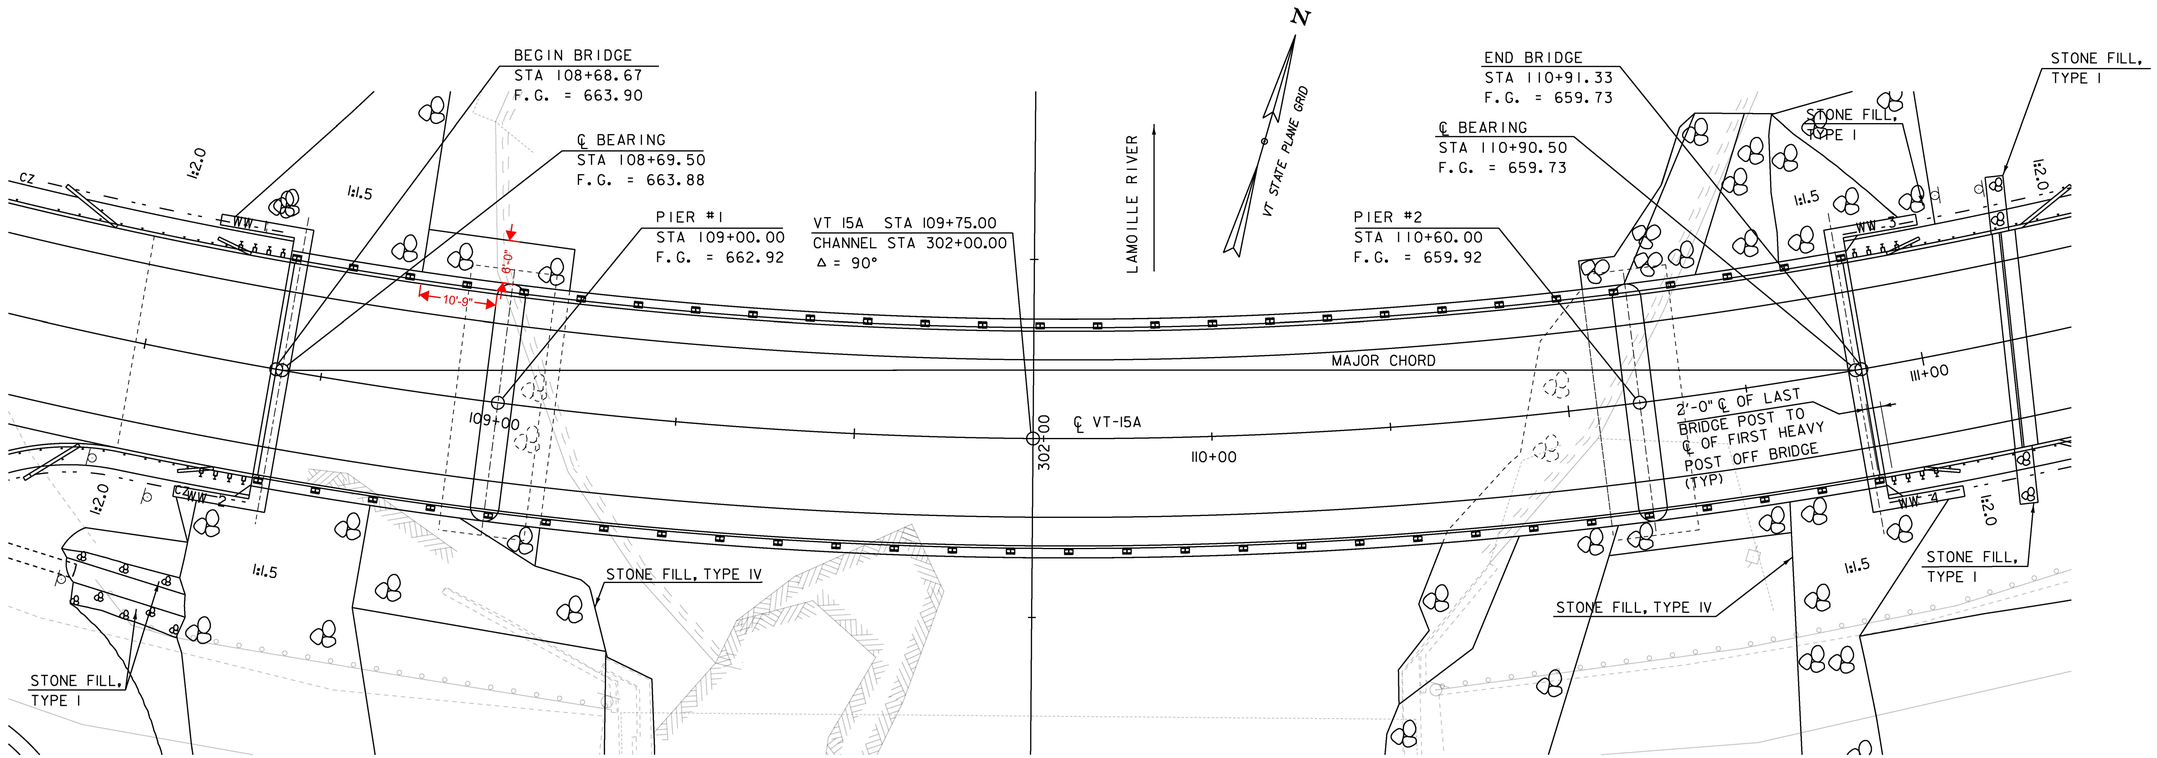

PLAN

SCALE 1" = 10'-0"

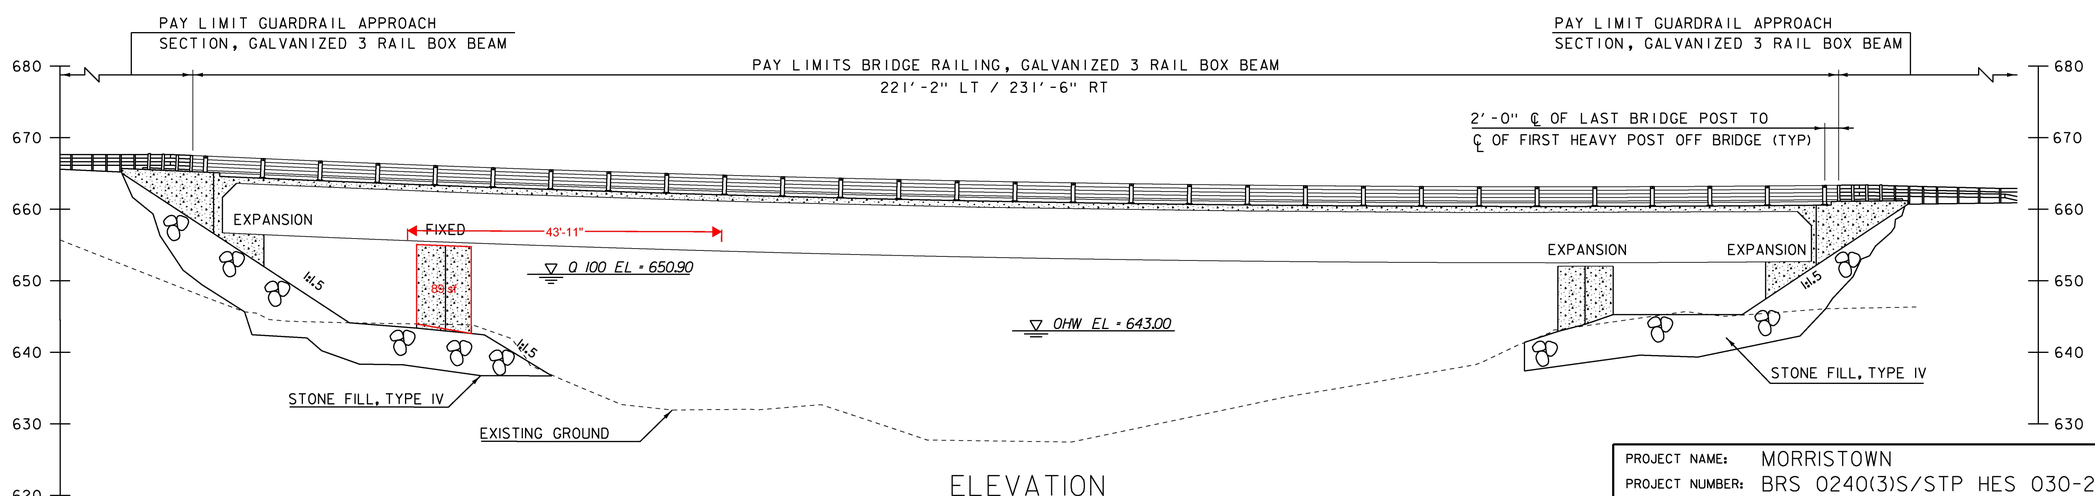

ELEVATION

SCALE 1" = 10'-0"

PROJECT NAME: MORRISTOWN	
PROJECT NUMBER: BRS 0240(3)S/STP HES 030-2(28)	
FILE NAME: s78f329pe.dgn	PLOT DATE: 12-APR-2017
PROJECT LEADER: C. CARLSON	DRAWN BY: G. ROKES
DESIGNED BY: C. BURRALL	CHECKED BY: J. LACROIX
PLAN AND ELEVATION	SHEET 79 OF 175