DIRECTION	MILEPOINT	LOCATION CODE (SHEET 2)	SIGN CODE	WIDTH (IN)	HEIGHT (IN)	SHEETING REMARKS	SIGN LEGEND	NEW SIGNS "A"	NEW SIGNS "B"	EXISTING SIGNS RETAIN	EXISTING SIGNS SALVAGE FROM	EXISTING SIGNS SALVAGE TO	EXISTING SIGNS REMOVE	EXIST POST RETAIN	EXIST POST REMOVE	NUMBER OF NEW POSTS	SQUARE STEEL (IN) 1.75 (LB / FT) 1.88	SQUARE STEEL (IN) 2.00 (LB / FT) 2.42	SQUARE STEEL (IN) 2.50 (LB / FT) 3.35	FOUNDATION	TUBULAR STEEL Ø (IN) 3.00 (LB / FT) 7.60	TUBULAR STEEL Ø (IN) 3.50 (LB / FT) 9.00	TUBULAR STEEL Ø (IN) 4.00 (LB / FT) 10.80	TUBULAR STEEL Ø (IN) 5.00 (LB / FT) 14.60	SIGN FRAME REQUIRED	REMARKS	SIGN DETAIL LOCATION SHSM	SIGN DETAIL LOCATION PROJECT SHEET #	SIGN DETAIL LOCATION STANDARD SHEET #
ALBURGH VT78 WB							FY-FLUORESCENT YELLOW FYG-FLUORESCENT YELLOW GREEN																			"SHSM"-STANDARD HIGHWAY SIGNS AND MARKINGS			
		G	R2-1	24	30								~~1~~															
		G	VR-017	24	30			5.00								1		X								BOUTAH RD (TH-6)		7	
		G	R2-1	24	30			5.00																			X		
WB	1.603	H	R1-1	30	30								3 ~~1~~		X														
		F	D3-1	42	12		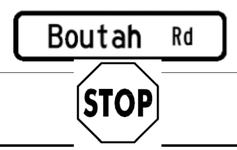	3.50							1		X								INSTALL SIGN ABOVE STOP SIGN.		5	
		H	R1-1	30	30			6.25																		BOUTAH RD (TH-6)	X		
WB	1.400	F	S3-1T	30	30		SCHOOL BUS STOP AHEAD (TEXT)						1		X														
		F	S3-1	36	36	FYG		9.00								2		X									X		
WB	1.260	F	VD-062B	72	16		BUSINESS SIGN			1				X															
WB	1.210	F	W2-2MR	30	30		MODIFIED RIGHT SIDE RD			1				X															
		F	W16-8A	24	8		MARTELL RD PLAQUE			1																			
WB	1.160	G	VR-017	24	30								1		X														
		G	R2-1	24	30		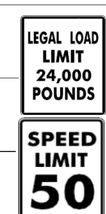						1															
		G	VR-017	24	30			5.00								1		X								MARTELL RD (TH-11)		7	
		G	R2-1	24	30			5.00																			X		
SIGN SUMMARY SHEET							SHEET TOTALS	38.75	0.00	3	0	0	~~5~~ 6	0	0	5		75.0		0	0.0	0.0	0.0	0.0					
								SF	SF	EA	EA	EA	EA	EA	EA	EA		FT		EA	LB	LB	LB	LB					
VERMONT AGENCY OF TRANSPORTATION							TOWN DIRECTIONAL TOTALS	153.8	0.0	19	0	0	31	0	0	17		255.0		0	0.0								

PROJECT NAME: **Statewide-NW Region**
PROJECT NUMBER: **STPG SIGN(42)**

FILE NAME: **Alburgh VT78WB.xls**
PROJECT MANAGER: **A. Gamble**
DESIGNED BY: **T. Guazzoni**
ALBURGH VT78 WB SHEET 2

PLOT DATE: **8/30/2012**
DRAWN BY: **T. Guazzoni**
CHECKED **A. Gamble**