DIRECTION	MILEPOINT	LOCATION CODE (SHEET 2)	SIGN CODE	WIDTH (IN)	HEIGHT (IN)	SHEETING REMARKS	SIGN LEGEND	NEW SIGNS "A"	NEW SIGNS "B"	EXISTING SIGNS RETAIN	EXISTING SIGNS SALVAGE FROM	EXISTING SIGNS SALVAGE TO	EXISTING SIGNS REMOVE	EXIST POST RETAIN	EXIST POST REMOVE	NUMBER OF NEW POSTS	SQUARE STEEL (IN) 1.75 (LB / FT) 1.88	SQUARE STEEL (IN) 2.00 (LB / FT) 2.42	SQUARE STEEL (IN) 2.50 (LB / FT) 3.35	FOUNDATION	TUBULAR STEEL Ø (IN) 3.00 (LB / FT) 7.60	TUBULAR STEEL Ø (IN) 3.50 (LB / FT) 9.00	TUBULAR STEEL Ø (IN) 4.00 (LB / FT) 10.80	TUBULAR STEEL Ø (IN) 5.00 (LB / FT) 14.60	SIGN FRAME REQUIRED	REMARKS	SIGN DETAIL LOCATION SHSM	SIGN DETAIL LOCATION PROJECT SHEET #	SIGN DETAIL LOCATION STANDARD SHEET #
ALBURGH VT78 WB							FY-FLUORESCENT YELLOW FYG-FLUORESCENT YELLOW GREEN																			"SHSM"-STANDARD HIGHWAY SIGNS AND MARKINGS			
WB	1.163	H	R1-1	30	30								~~1~~ 2		X														
		F	D3-1	42	12		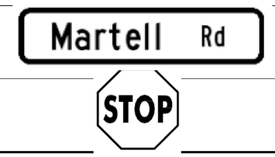	3.50																		INSTALL SIGN ABOVE STOP SIGN.		5	
		H	R1-1	30	30			6.25								1		X								MARTELL RD (TH-11)	X		
WB	1.010	F	W1-2L	30	30		LEFT CURVE						1		X														
WB	0.960	F	VW-622A	36	36		RECREATIONAL TRAIL						~~1~~	~~X~~															
		F	W1-7	24	12		<---> DOUBLE ARROW						~~1~~																
		F	W11-15A	30	30			6.25																			X		
		F	W7-3A	24	18			3.00																			X		
WB	0.91	F	W1-2L	30	30			6.25								1		X							INSTALL 260' +/- WEST OF EXISTING LEFT CURVE SIGN	X		
WB	0.350	F	VD-062AL	72	16		BUSINESS SIGN			1				X															
WB	0.230	F	W3-1	36	36								1	X															
		F	W3-1	36	36		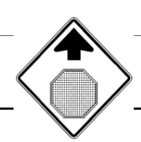	9.00																	RETAIN FLASHING BEACONS	X		
WB	0.170	F	M2-1	21	15		ROUTE MARKER ASSEMBLY						1		X														
		F	M1-4	24	24								1																
							SHEET TOTALS	34.25	0.00	1	0	0	~~7~~ 6	0	0	2		30.0		0	0.0	0.0	0.0	0.0					
								SF	SF	EA	EA	EA	EA	EA	EA	EA		FT		EA	LB	LB	LB	LB					
							TOWN DIRECTIONAL TOTALS	153.8	0.0	19	0	0	31	0	0	17		255.0		0		0.0							

SIGN SUMMARY SHEET

VERMONT AGENCY OF TRANSPORTATION

PROJECT NAME: **Statewide-NW Region**
PROJECT NUMBER: **STPG SIGN(42)**

FILE NAME: **Alburgh VT78WB.xls**
PROJECT MANAGER: **A. Gamble**
DESIGNED BY: **T. Guazzoni**
ALBURGH VT78 WB SHEET 3

PLOT DATE: **8/30/2012**
DRAWN BY: **T. Guazzoni**
CHECKED **A. Gamble**