DIRECTION	MILEPOINT	LOCATION CODE (SHEET 2)	SIGN CODE	WIDTH (IN)	HEIGHT (IN)	SHEETING REMARKS	SIGN LEGEND	NEW SIGNS "A"	NEW SIGNS "B"	EXISTING SIGNS RETAIN	EXISTING SIGNS SALVAGE FROM	EXISTING SIGNS SALVAGE TO	EXISTING SIGNS REMOVE	EXIST POST RETAIN	EXIST POST REMOVE	NUMBER OF NEW POSTS	SQUARE STEEL (IN) 1.75 (LB / FT) 1.88	SQUARE STEEL (IN) 2.00 (LB / FT) 2.42	SQUARE STEEL (IN) 2.50 (LB / FT) 3.35	FOUNDATION	TUBULAR STEEL Ø (IN) 3.00 (LB / FT) 7.60	TUBULAR STEEL Ø (IN) 3.50 (LB / FT) 9.00	TUBULAR STEEL Ø (IN) 4.00 (LB / FT) 10.80	TUBULAR STEEL Ø (IN) 5.00 (LB / FT) 14.60	SIGN FRAME REQUIRED	REMARKS	SIGN DETAIL LOCATION SHSM	SIGN DETAIL LOCATION PROJECT SHEET #	SIGN DETAIL LOCATION STANDARD SHEET #
SWANTON VT78 EB							FY-FLUORESCENT YELLOW FYG-FLUORESCENT YELLOW GREEN																			"SHSM"-STANDARD HIGHWAY SIGNS AND MARKINGS			
		B	M6-1R	21	15								1															
		B	M3-3	24	12			2.00								2 ~~1~~		X							#2	BLACK ON WHITE. INSTALL ASSEMBLY IN SAME POSITION AS EXISTING	X	6	
		B	M1-5A	24	24			4.00																				E-136C
		B	M6-1L	21	15			2.19																		GREEN ON WHITE	X		
		B	M3-4	12	24		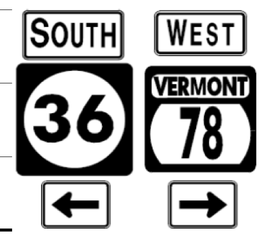	2.00																		GREEN ON WHITE	X		
		B	M1-5	24	24			4.00																				E-136B
		B	M6-1R	21	15			2.19																		GREEN ON WHITE	X		
EB	6.511	C	VR-017	24	30		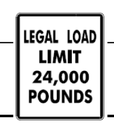						0 ~~1~~		~~X~~													
		C	VR-017	24	30		NOT INSTALLED	0 ~~5.00~~								~~1~~		~~X~~								N. RIVER ST (TH-3)		7	
EB	6.519	C	D3-1	UNK	UNK		S. RIVER ST STREET NAME SIGN				~~1~~	~~1~~	~~1~~		X	1		X										
		A	D3-1	UNK	UNK		DEPOT ST STREET NAME SIGN				~~1~~	~~1~~	~~1~~															
		D	R1-1	30	30								~~1~~															
		D	R1-4	18	6								~~1~~															
		D	R1-1	30	30			6.25									1									DEPOT ST (TH-110)	X		
		D	R1-3P	18	6			0.75																			X	
							SHEET TOTALS	23.38 ~~28.38~~	0.00	0	0 ~~2~~	0 ~~2~~	1 ~~6~~	0	0	~~3~~		45.0		0	0.0	0.0	0.0	0.0					
								SF	SF	EA	EA	EA	EA	EA	EA	EA		FT		EA	LB	LB	LB	LB				
							TOWN DIRECTIONAL TOTALS	445.7	0.0	97	4	4	104	0	0	57		855.0		0		0.0						

SIGN SUMMARY SHEET

VERMONT AGENCY OF TRANSPORTATION

PROJECT NAME: Statewide-NW Region
PROJECT NUMBER: STPG SIGN(42)

FILE NAME: Swanton VT78EB.xls
PROJECT MANAGER: A. Gamble
DESIGNED BY: T. Guazzoni
SWANTON VT78 EB SHEET 9

PLOT DATE: 8/30/2012
DRAWN BY: T. Guazzoni
CHECKED: A. Gamble