DIRECTION	MILEPOINT	LOCATION CODE (SHEET 2)	SIGN CODE	WIDTH (IN)	HEIGHT (IN)	SHEETING REMARKS	SIGN LEGEND	NEW SIGNS "A"	NEW SIGNS "B"	EXISTING SIGNS RETAIN	EXISTING SIGNS SALVAGE FROM	EXISTING SIGNS SALVAGE TO	EXISTING SIGNS REMOVE	EXIST POST RETAIN	EXIST POST REMOVE	NUMBER OF NEW POSTS	SQUARE STEEL (IN) 1.75 (LB / FT) 1.88	SQUARE STEEL (IN) 2.00 (LB / FT) 2.42	SQUARE STEEL (IN) 2.50 (LB / FT) 3.35	FOUNDATION	TUBULAR STEEL Ø (IN) 3.00 (LB / FT) 7.60	TUBULAR STEEL Ø (IN) 3.50 (LB / FT) 9.00	TUBULAR STEEL Ø (IN) 4.00 (LB / FT) 10.80	TUBULAR STEEL Ø (IN) 5.00 (LB / FT) 14.60	SIGN FRAME REQUIRED	REMARKS	SIGN DETAIL LOCATION SHSM	SIGN DETAIL LOCATION PROJECT SHEET #	SIGN DETAIL LOCATION STANDARD SHEET #
SWANTON VT78 EB							FY-FLUORESCENT YELLOW FYG-FLUORESCENT YELLOW GREEN																			"SHSM"-STANDARD HIGHWAY SIGNS AND MARKINGS			
EB	6.821	A	W11-2	30	30		PEDESTRIAN SYMBOL			1				X															
		A	W16-7	24	18		DIAGONAL ARROW			1																			
EB	6.826	A	UNK	UNK	UNK		NO THRU TRUCKS						1	X												REMOVE SIGN. RETURN TO TOWN			
		A	VR-017	24	30			~~5.00~~																		YORK ST (TH-144)		7	
EB	6.829	C	D3-1	UNK	UNK		FIRST ST STREET NAME SIGN			1				X															
		A	D3-1	UNK	UNK		YORK ST STREET NAME SIGN			1																			
		D	R1-1	30	30								1																	
		D	R1-1	30	30			~~6.25~~																		YORK ST (TH-144)	X		
EB	6.840	A	R2-1	24	30								1		X															
		A	R2-1	24	30			5.00								1		X									X		
EB	6.903	C	VR-017	24	30		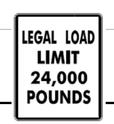						~~1~~		~~X~~															
		C	VR-017	24	30			5.00								1		X								BROADWAY ST (TH-105)		7	
EB	6.906	D	R1-1	30	30								1		X															
		D	R1-1	30	30			6.25								1		X								BROADWAY ST (TH-105)	X		
EB	6.981	C	VR-017	24	30								~~1~~		~~X~~														
							SHEET TOTALS	~~27.50~~ 16.25	0.00	4	0	0	6 4	0	0	3		45.0		0	0.0	0.0	0.0	0.0					
								SF	SF	EA	EA	EA	EA	EA	EA	EA		FT		EA	LB	LB	LB	LB					
							TOWN DIRECTIONAL TOTALS	445.7	0.0	97	4	4	104	0	0	57		855.0		0		0.0							

SIGN SUMMARY SHEET

VERMONT AGENCY OF TRANSPORTATION

PROJECT NAME: **Statewide-NW Region**
PROJECT NUMBER: **STPG SIGN(42)**

FILE NAME: **Swanton VT78EB.xls** PLOT DATE: **8/30/2012**
PROJECT MANAGER: **A. Gamble** DRAWN BY: **T. Guazzoni**
DESIGNED BY: **T. Guazzoni** CHECKED **A. Gamble**