DIRECTION	MILEPOINT	LOCATION CODE (SHEET 2)	SIGN CODE	WIDTH (IN)	HEIGHT (IN)	SHEETING REMARKS	SIGN LEGEND	NEW SIGNS "A"	NEW SIGNS "B"	EXISTING SIGNS RETAIN	EXISTING SIGNS SALVAGE FROM	EXISTING SIGNS SALVAGE TO	EXISTING SIGNS REMOVE	EXIST POST RETAIN	EXIST POST REMOVE	NUMBER OF NEW POSTS	SQUARE STEEL (IN) 1.75 (LB / FT) 1.88	SQUARE STEEL (IN) 2.00 (LB / FT) 2.42	SQUARE STEEL (IN) 2.50 (LB / FT) 3.35	FOUNDATION	TUBULAR STEEL Ø (IN) 3.00 (LB / FT) 7.60	TUBULAR STEEL Ø (IN) 3.50 (LB / FT) 9.00	TUBULAR STEEL Ø (IN) 4.00 (LB / FT) 10.80	TUBULAR STEEL Ø (IN) 5.00 (LB / FT) 14.60	SIGN FRAME REQUIRED	REMARKS	SIGN DETAIL LOCATION SHSM	SIGN DETAIL LOCATION PROJECT SHEET #	SIGN DETAIL LOCATION STANDARD SHEET #
SWANTON VT78 WB							FY-FLUORESCENT YELLOW FYG-FLUORESCENT YELLOW GREEN																			"SHSM"-STANDARD HIGHWAY SIGNS AND MARKINGS			
		F	M3-1	24	12			2.00																		BLACK ON WHITE	X		
		F	M1-4	24	24			4.00																			X		
		F	M6-1R	21	15			2.19																		BLACK ON WHITE	X		
WB	6.715	F	W11-2	30	30		PEDESTRIAN SYMBOL			1				X															
		F	W16-7	24	18		DIAGONAL ARROW			1																			
WB	6.56	F	W3-1	36	36								1		X														
		F	W3-1	36	36		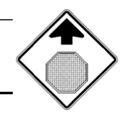	9.00								2		X								X		
		F	D3-1	UNK	UNK		FOUNDRY ST STREET NAME SIGN			1				X															
		G	D3-1	UNK	UNK		MERCHANTS ROW STREET NAME SIGN			1																			
WB	6.551	H	R1-1	30	30								1																
		H	R1-1	30	30			6.25																	FOUNDRY ST (TH-116)	X		
WB	6.53	F	M2-1	24	12								~~1~~ 2		X														
		F	M1-6	24	24								~~1~~ 2																
		F	M2-1	24	12			2.00								1		X								BLACK ON WHITE	X		
		F	M1-5A	24	24			4.00																					E-136C
							SHEET TOTALS	29.44	0.00	4	0	0	~~4~~ 6	0	0	3		45.0		0	0.0	0.0	0.0	0.0					
								SF	SF	EA	EA	EA	EA	EA	EA	EA		FT		EA	LB	LB	LB	LB					
							TOWN DIRECTIONAL TOTALS	334.3	0.0	73	19	19	89	0	0	45		675.0		0		0.0							

SIGN SUMMARY SHEET

VERMONT AGENCY OF TRANSPORTATION

PROJECT NAME: **Statewide-NW Region**
PROJECT NUMBER: **STPG SIGN(42)**

FILE NAME: **Swanton VT78WB.xls**
PROJECT MANAGER: **A. Gamble**
DESIGNED BY: **T. Guazzoni**
CHECKED **A. Gamble**
PLOT DATE: **8/30/2012**
DRAWN BY: **T. Guazzoni**