DIRECTION	MILEPOINT	LOCATION CODE (SHEET 2)	SIGN CODE	WIDTH (IN)	HEIGHT (IN)	SHEETING REMARKS	SIGN LEGEND	NEW SIGNS "A"	NEW SIGNS "B"	EXISTING SIGNS RETAIN	EXISTING SIGNS SALVAGE FROM	EXISTING SIGNS SALVAGE TO	EXISTING SIGNS REMOVE	EXIST POST RETAIN	EXIST POST REMOVE	NUMBER OF NEW POSTS	SQUARE STEEL (IN) 1.75 (LB / FT) 1.88	SQUARE STEEL (IN) 2.00 (LB / FT) 2.42	SQUARE STEEL (IN) 2.50 (LB / FT) 3.35	FOUNDATION	TUBULAR STEEL Ø (IN) 3.00 (LB / FT) 7.60	TUBULAR STEEL Ø (IN) 3.50 (LB / FT) 9.00	TUBULAR STEEL Ø (IN) 4.00 (LB / FT) 10.80	TUBULAR STEEL Ø (IN) 5.00 (LB / FT) 14.60	SIGN FRAME REQUIRED	REMARKS	SIGN DETAIL LOCATION SHSM	SIGN DETAIL LOCATION PROJECT SHEET #	SIGN DETAIL LOCATION STANDARD SHEET #
SWANTON VT78 WB							FY-FLUORESCENT YELLOW FYG-FLUORESCENT YELLOW GREEN																			"SHSM"-STANDARD HIGHWAY SIGNS AND MARKINGS			
WB	3.000	F	W1-4L	30	30		LEFT REVERSE CURVE			1				X															
WB	2.130	F	W2-2MR	30	30		MODIFIED RIGHT SIDE ROAD			1				X															
		F	W16-8A	42	8		CAMPBELL BAY RD			1																			
WB	2.000	E	VR-020	24	30								1		X														
		F	VR-020	24	30								1																
		E	VR-020	24	30			5.00								1		X								INSTALL SIGNS BACK TO BACK		6	
		F	VR-020	24	30			5.00																				6	
WB	1.997	G	VR-017	24	30								1		X														
		G	VR-017	24	30			5.00								1		X								CAMPBELL BAY RD (TH-10)		7	
WB	1.997	H	R1-1	30	30								~~1~~ 2		X														
		H	R1-1	30	30			6.25								1		X								CAMPBELL BAY RD (TH-10)	X		
WB	1.997	F	D3-1	54	12		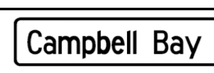	4.50								2		X								SIGN LOCATIONS TO BE DETERMINED IN FIELD		5	
		G	D3-1	42	12			3.50																				5	
WB	1.960	F	VR-023B	24	30																								
		F	VR-023B	24	30			5.00								1		X										6	
							SHEET TOTALS	34.25	0.00	3	0	0	~~5~~ 6	0	0	6		90.0		0	0.0	0.0	0.0	0.0					
								SF	SF	EA	EA	EA	EA	EA	EA	EA		FT		EA	LB	LB	LB	LB					
							TOWN DIRECTIONAL TOTALS	334.3	0.0	73	19	19	89	0	0	45		675.0		0		0.0							

SIGN SUMMARY SHEET

VERMONT AGENCY OF TRANSPORTATION

PROJECT NAME: **Statewide-NW Region**
PROJECT NUMBER: **STPG SIGN(42)**

FILE NAME: **Swanton VT78WB.xls**
PROJECT MANAGER: **A. Gamble**
DESIGNED BY: **T. Guazzoni**
SWANTON VT78 WB SHEET 15

PLOT DATE: **8/30/2012**
DRAWN BY: **T. Guazzoni**
CHECKED BY: **A. Gamble**