DIRECTION	MILEPOINT	LOCATION CODE (SHEET 2)	SIGN CODE	WIDTH (IN)	HEIGHT (IN)	SHEETING REMARKS	SIGN LEGEND	NEW SIGNS "A"	NEW SIGNS "B"	EXISTING SIGNS RETAIN	EXISTING SIGNS SALVAGE FROM	EXISTING SIGNS SALVAGE TO	EXISTING SIGNS REMOVE	EXIST POST RETAIN	EXIST POST REMOVE	NUMBER OF NEW POSTS	SQUARE STEEL (IN) 1.75 (LB / FT) 1.88	SQUARE STEEL (IN) 2.00 (LB / FT) 2.42	SQUARE STEEL (IN) 2.50 (LB / FT) 3.35	TUBULAR STEEL Ø (IN) FOUNDATION	TUBULAR STEEL Ø (IN) 3.00 (LB / FT) 7.60	TUBULAR STEEL Ø (IN) 3.50 (LB / FT) 9.00	TUBULAR STEEL Ø (IN) 4.00 (LB / FT) 10.80	TUBULAR STEEL Ø (IN) 5.00 (LB / FT) 14.60	SIGN FRAME REQUIRED	REMARKS	SIGN DETAIL LOCATION SHSM	SIGN DETAIL LOCATION PROJECT SHEET #	SIGN DETAIL LOCATION STANDARD SHEET #
HIGHGATE US7 SB							FY-FLUORESCENT YELLOW FYG-FLUORESCENT YELLOW GREEN																		"SHSM"-STANDARD HIGHWAY SIGNS AND MARKINGS			
SB	5.505	H	R1-1	30	30								1		X													
		F	D3-1	UNK	UNK		HUMPHREY RD STREET NAME SIGN						1															
		H	R1-1	30	30			6.25								1		X							HUMPHREY RD (TH-8)	X		
SB	5.505	F	D3-1	60	12		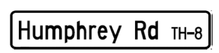	5.00								2		X							SIGN LOCATION TO BE DETERMINED IN FIELD		5	
SB	5.173	F	W11-2	30	30		PEDESTRIAN SYMBOL			1				X														
SB	5.173	F	VW-258	24	18		DEAF PERSON			1																		
SB	5.135	F	S3-1	36	36		SCHOOL BUS STOP AHEAD			1				X														
SB	5.080	F	W1-4R	30	30		RIGHT REVERSE CURVE			1				X														
		F	W13-1	18	18		40 MPH PLAQUE			1																		
SB	4.200	F	UNK	UNK	UNK		CHAMPLAIN BIKEWAY			1				X														
		F	UNK	UNK	UNK		UP ARROW			1																		
SB	3.160	F	W3-5	36	36		SPEED REDUCTION 40 MPH			1				X														
SB	3.110	F	VD-018	30	18		VILLAGE SIGN			1				X														
SB	3.064	F	R2-1	24	30		NOT INSTALLED						~~1~~	X		~~1~~												
		F	R2-1	30	36			7.50																			X	
SIGN SUMMARY SHEET							SHEET TOTALS	18.75	0.00	9	0	0	~~3~~ 2	0	0	~~3~~ 4		45.0		0	0.0	0.0	0.0	0.0				
								SF	SF	EA	EA	EA	EA	EA	EA	EA		FT		EA	LB	LB	LB	LB				
VERMONT AGENCY OF TRANSPORTATION							TOWN DIRECTIONAL TOTALS	60.9	0.0	37	3	3	14	0	0	9		135.0		0	0.0							

PROJECT NAME: **Statewide-NW Region**
PROJECT NUMBER: **STPG SIGN(42)**

FILE NAME: **Highgate us7SB.xls**
PROJECT MANAGER: **A. Gamble**
DESIGNED BY: **T. Guazzoni**
HIGHGATE US7 SB SHEET 4

PLOT DATE: **8/17/2012**
DRAWN BY: **T. Guazzoni**
CHECKED **A. Gamble**