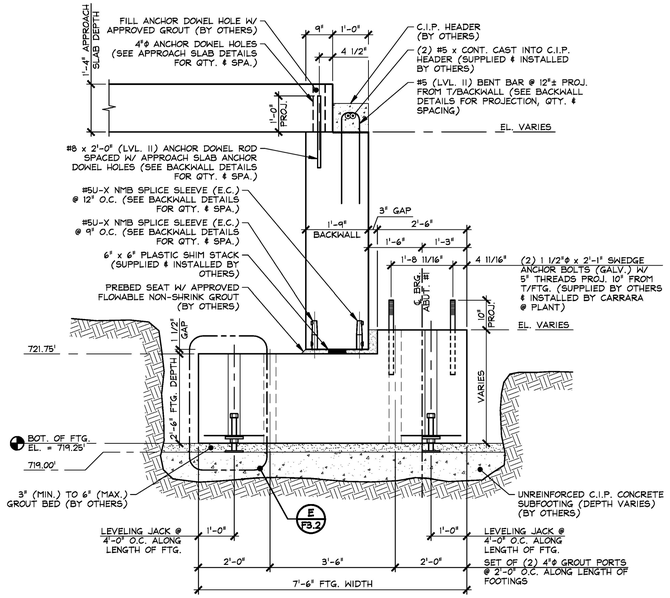

A F3.2 ABUTMENT #1 SECTION
1/2" = 1'-0"

GROUT NMB SPLICE SLEEVES WITH SS MORTAR IN ACCORDANCE W/ MFR. INSTRUCTIONS

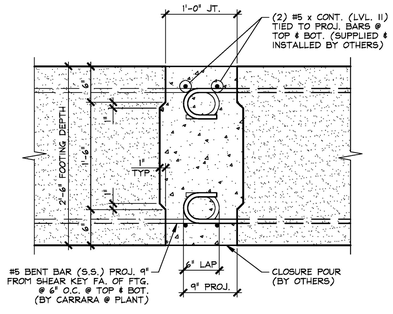

B F3.2 FOOTING CLOSURE POUR
1" = 1'-0"

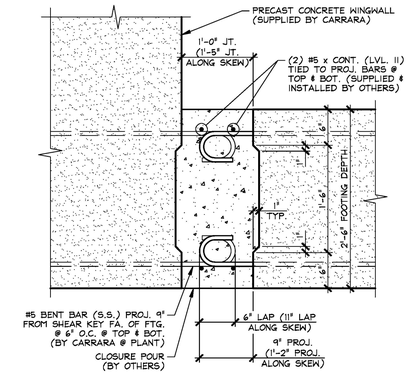

C F3.2 FOOTING CLOSURE POUR @ WINGWALL
1" = 1'-0"

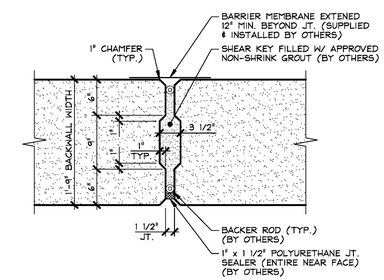

D F3.2 BACKWALL VERTICAL JOINT
1" = 1'-0"

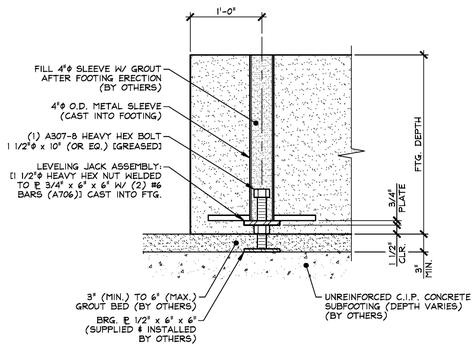

E F3.2 LEVELING JACK DETAIL
1" = 1'-0"

Vermont Agency of Transportation
RECEIVED
ON: May 10, 2016
and Checked for
CONFORMANCE
BY: Rob Young DATE: 05/16/2016

_____ Approved
_____ Rejected
X Approved As Noted

This review is only for general conformance with the design concept and the information given in the Construction Documents. Corrections or comments made on the shop drawings during the review do not relieve the Contractor from compliance with the requirements of the Plans and Specifications. Review of a specific item shall not include review of an assembly of which an item is a component. The Contractor is responsible for dimensions to be confirmed and corrected at the job site; information that pertains solely to the fabrication process or to the means, methods, techniques, sequences and procedures of construction; coordination of the Work with that of other trades and performing all Work in a safe and satisfactory manner.

McFarland Johnson
Date 5/13/2016
By D. Kull

APPROVAL STAMP:

J.P. CARRARA & SONS INC.
Precast & Prestress Manufacturer
2464 OASE STR., MIDDLEBURY, VERMONT 05753 Phone:(802)388-6361 Fax:(802)388-9010

A.L. ST. ONGE CONTRACTOR, INC.
CONTRACTOR
MONTGOMERY, VERMONT

STATE OF VERMONT AGENCY OF TRANSPORTATION
COUNTY OF WINDSOR

DATE: JAN. 12, 2016
SCALE: NOTED
CHKD: - DFTM: B.L.
JOB NO: 23480-016

TOWN OF WAITSFIELD
VT ROUTE 100 (MINOR ARTERIAL)
BRIDGE NO.: 177 PROJECT NO.: BRF 013-4(39)

ABUTMENT #1 DETAILS

DWG. NO: F3.2

F:\VT-Bridges\23480-15 Waitsfield\23480-F3-2.dwg, 5/10/2016 10:30:56 AM