Vermont Agency of Transportation
BRF 015-2 Relist Rev 1_REVIEW Approved.pdf
RECEIVED
ON: June 10, 2015
and Checked for
CONFORMANCE
BY: Jennifer Fitch DATE: 06/15/2015

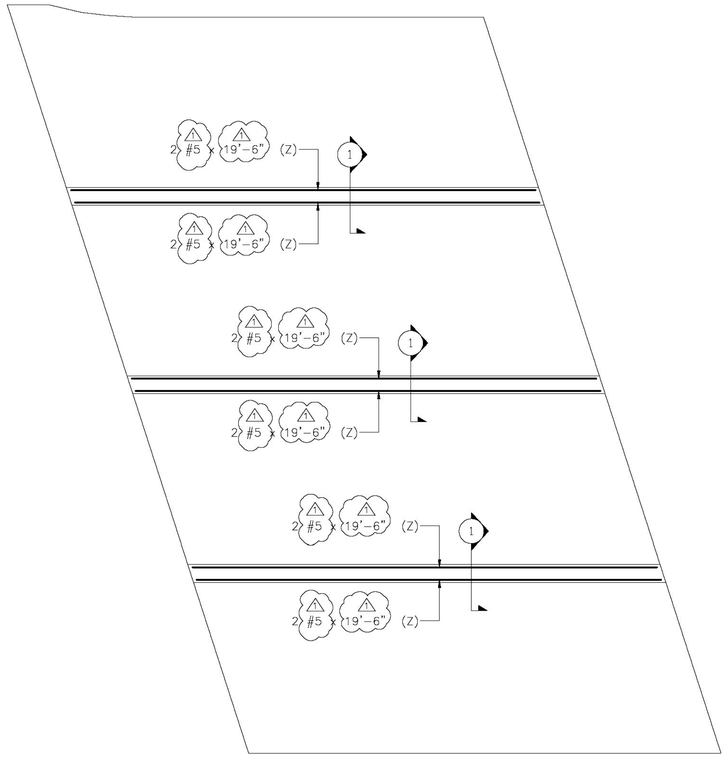

APPROACH SLAB #1 CLOSURE POURS PLAN

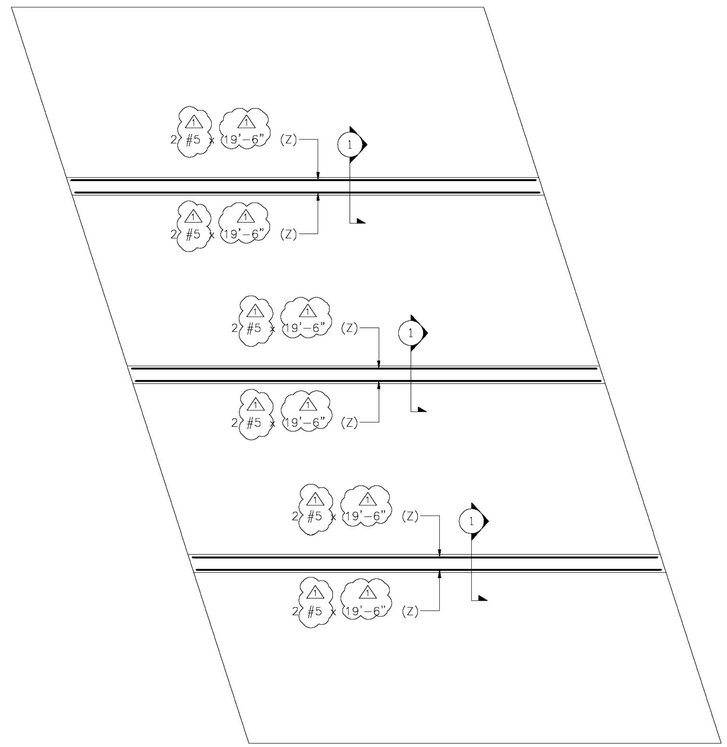

APPROACH SLAB #2 CLOSURE POURS PLAN

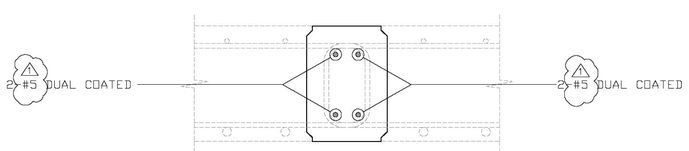

(3 THUS)

SECT. 1

ALL DUAL COATED REINF. DENOTED (Z)

ELEVATIONS & DIMENSIONS SHOWN ON THIS DWG. ARE FOR REINF. DETAILING PURPOSES ONLY AND ARE NOT INTENDED FOR CONSTRUCTION.

REINF. BARS ASTM A615 GRADE 60 DUAL COATED

VERIFICATION OF UNCLEAR INFORMATION MAY BE REQUESTED ON THIS DRAWING. SHOULD VERIFICATION BE LEFT UN-ADDRESSED IT WILL REMAIN AS SHOWN AND ASSUME TO BE CORRECT.

FOR APPROVAL

6			
5			
4			
3			
2	6/10/15	⚠	REVISED/ENG. COMM/FOR APPROVAL
1	4/29/15		FOR APPROVAL
	DATE	REV.#	SENT FOR

DIMENSION
DIMENSION FABRICATORS INC.
2000 7TH STREET
SCOTIA, N.Y. 12302
PH: (518) 374-1935
FAX: (518) 374-4830
www.dimensionfabricators.com

STRUCTURE	CASTLETON BRF 015-2(10) CLOSURE POURS REINFORCING
LOCATION	CASTLETON, VT
ARCHITECT	
ENGINEER	
CUSTOMER	W.M. SCHULTZ CONSTRUCTION INC.
DRAWN BY	Ed Eras
DATE	4/29/15
OFF #	9248
DRAWING COVERS	APPROACH SLABS CLOSURE POURS DUAL COATED REINFORCING
DRAWING #	B

SHOP DRAWING REVIEW

✕ REVIEWED AS REQUIRED BY THE CONSTRUCTION CONTRACT DOCUMENTS AND APPROVED, BUT ONLY FOR CONFORMANCE TO THE DESIGN CONCEPT OF THE WORK, AND SUBJECT TO FURTHER LIMITATIONS AND REQUIREMENTS CONTAINED IN THE CONSTRUCTION CONTRACT DOCUMENTS.

☐ REJECTED ☐ REVISE AND RESUBMIT ☐ FURNISH AS CORRECTED

CORRECTIONS OR COMMENTS MADE ON THE SHOP DRAWINGS DURING THIS REVIEW DO NOT RELIEVE CONTRACTOR FROM COMPLIANCE WITH REQUIRMENTS OF THE DRAWINGS AND SPECIFICATIONS. THIS CHECK IS ONLY FOR REVIEW OF GENERAL CONFORMANCE WITH THE DESIGN CONCEPT OF THE PROJECT AND GENERAL COMPLIANCE WITH THE INFORMATION GIVEN IN THE CONTRACT DOCUMENTS. THE CONTRACTOR IS RESPONSIBLE FOR: CONFIRMING AND CORRELATING ALL QUANTITIES AND DIMENSIONS; SELECTING FABRICATION PROCESSES AND TECHNIQUES OF CONSTRUCTION; COORDINATING HIS WORK WITH THAT OF ALL OTHER TRADES; AND PERFORMING HIS WORK IN A SAFE AND SATISFACTORY MANNER.

vhb
40 IDX Drive
Building 100, Suite 200
South Burlington, VT 05403
802.497.6100

Job Number: 57632.00
Reviewed By: E.F. LAWES
Date: June 12, 2015