FIXED SPLICE TUBE DETAIL

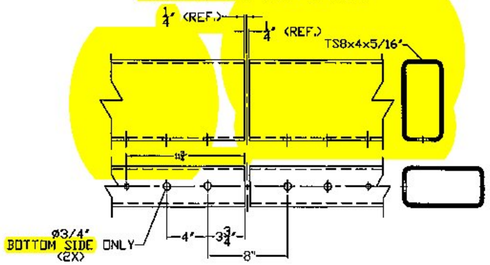

FIXED SPLICE TUBE DETAIL

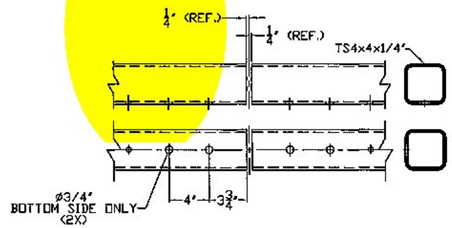

EXPANSION SPLICE TUBE DETAIL

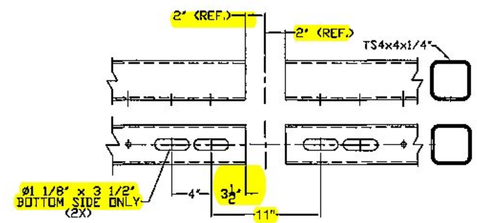

EXPANSION SPLICE TUBE DETAIL

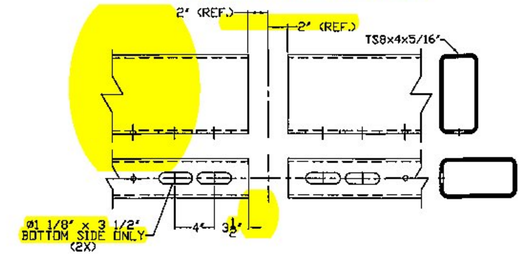

SPLICE FOR: TS8x4x5/16"

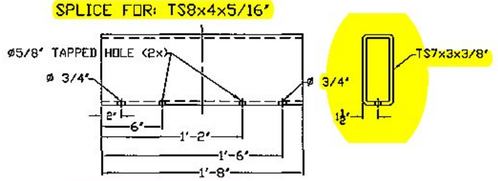

SPLICE FOR: TS4x4x1/4"

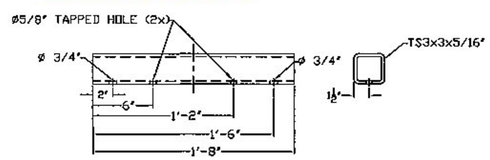

SPLICE FOR: TS4x4x1/4"

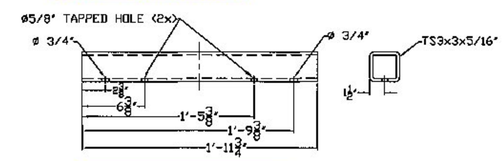

SPLICE FOR: TS8x4x5/16"

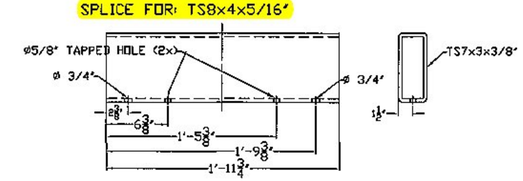

FIXED SPLICE ASS'Y

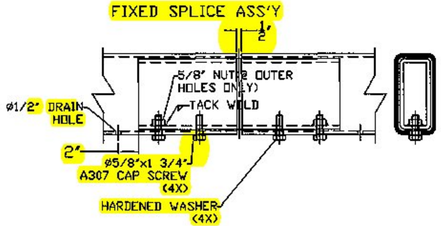

FIXED SPLICE ASS'Y

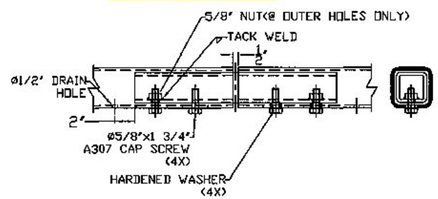

EXPANSION SPLICE ASS'Y

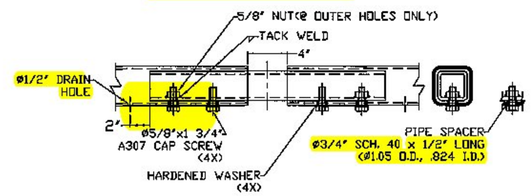

EXPANSION SPLICE ASS'Y

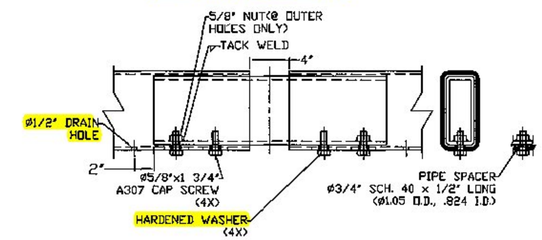

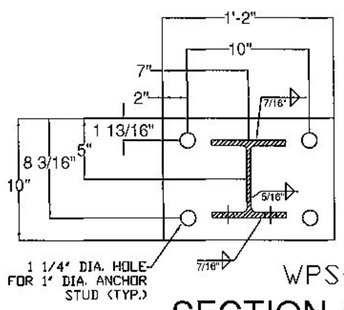

WPS-3027

SECTION A-A

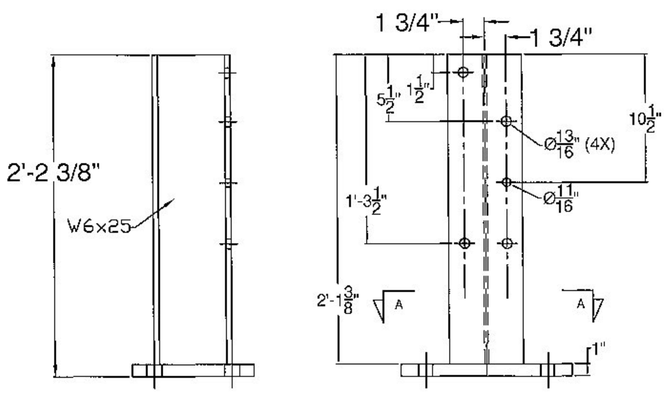

Vermont Agency of Transportation

RECEIVED

CK'D BY D. PETERSON OK'D BY C. CARLSON

June 1, 2015

RESUBMIT NO Approved

BY C. CARLSON DATE 06/12/2015

ITEM #: 525.33

SHEET 2 OF 2

STRUCTURAL STEEL TO COMPLY W/ ASTM A6

GALAVANIZING TO BE PER ASTM A123, UNLESS OTHERWISE SPECIFIED.

TOLERANCE UNLESS OTHERWISE NOTED:
HOLES - ± 1/32"
FRACTIONS - ± 1/16"
ANGLES - ± 1/2°

BRIDGE RAIL DETAILS SHEET

PROJECT: ANDOVER BHF 016-1 (29) VT RTE11, RURAL MINOR ARTERIAL, BRIDGE NO. 41
TOWN OF ANDOVER, WINDSOR COUNTY, VERMONT

R	NO.	DATE	DESCRIPTION	BY	R	NO.	DATE	DESCRIPTION	BY
E	1	5/28/15	REVISED PER 5/18/15 MARK-UP	E.P.	E				
V	2	5/29/15	REVISED PER 5/29/15 EMAIL	E.P.	V				

ELDERLEE, INC.
OAKS CORNERS, NEW YORK 14518
email: dlong@elderlee.com / epeek@elderlee.com
Tel: 315-789-6670 Fax: 315-789-6615

AISC CERTIFIED FABRICATOR

ORTHOGRAPHIC PROJECTION

DRAWN	E.P.	4/29/15
CHECKED	D.L.	4/29/15
APPROVED		
SCALE	SCHEMATIC	
DRAWING NO.	F.R.L. ANDOVER	