STEEL BEAM GUARDRAIL, GALVANIZED W/ 8 FT POSTS
STA A 368+80 - STA A 378+77 RT

STEEL BEAM GUARDRAIL, GALVANIZED
STA A 368+67 - STA A 368+80 RT

ANCHOR FOR STEEL BEAM RAIL
STA A 368+76 RT

DELINEATOR WITH STEEL POSTS
STA A 368+67 RT

REMOVE AND DISPOSE OF GUARDRAIL
STA A 368+84 - STA A 378+83 RT

STONE FILL, TYPE I
STA A 369+00 - STA A 377+00 RT

GRUBBING MATERIAL
STA A 369+00 - STA A 377+00

GEOTEXTILE FOR SILT FENCE
STA A 369+00 - STA A 377+00 RT

VT STATE PLANE GRID

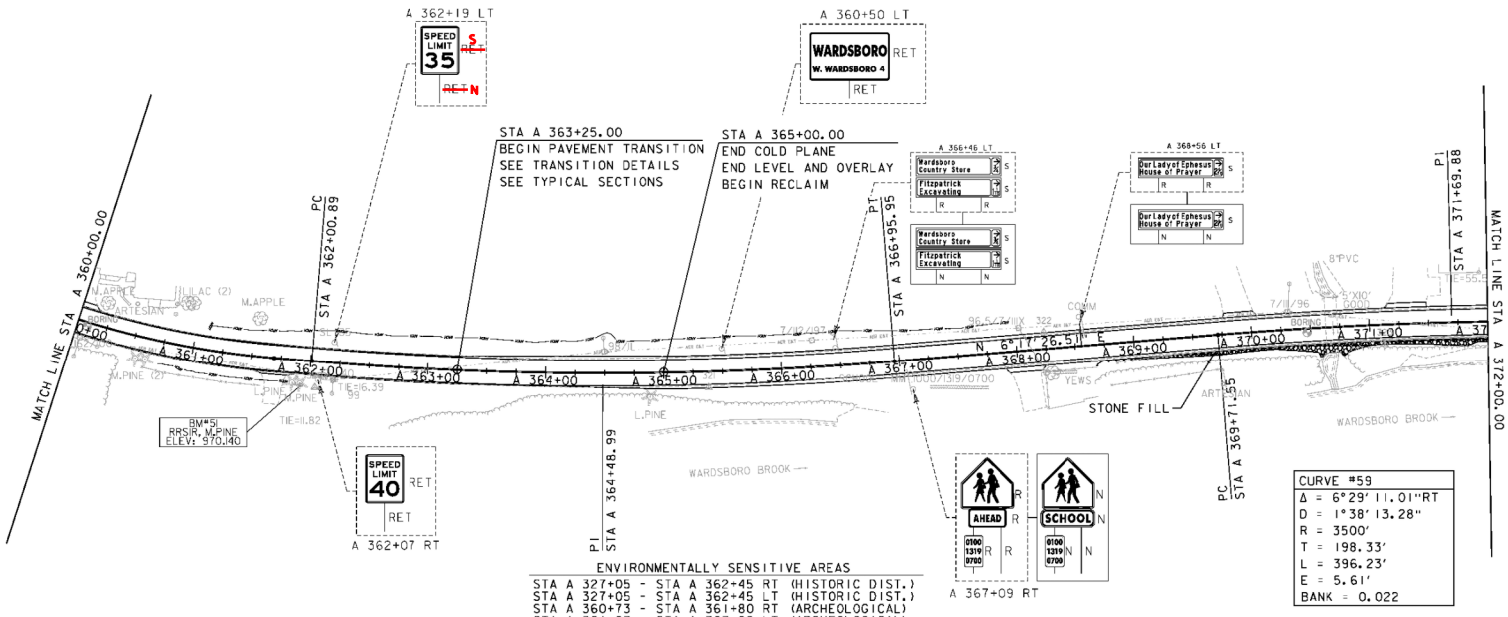

ENVIRONMENTALLY SENSITIVE AREAS
STA A 327+05 - STA A 362+45 RT (HISTORIC DIST.)
STA A 327+05 - STA A 362+45 LT (HISTORIC DIST.)
STA A 360+73 - STA A 361+80 RT (ARCHEOLOGICAL)
STA A 361+03 - STA A 367+92 LT (ARCHEOLOGICAL)

DURABLE 4 INCH WHITE LINE (SEE OPTION ITEMS)
STA A 343+77 - STA A 373+47 (SOLID LT)
STA A 346+96 - STA B 118+68 (SOLID RT)

TEMPORARY 4 INCH WHITE LINE
STA A 343+77 - STA A 373+47 (SOLID LT)
STA A 346+96 - STA B 118+68 (SOLID RT)

DURABLE LETTER OR SYMBOL (SEE OPTION ITEMS)
STA A 367+09 RT "SCHOOL"

DURABLE 4 INCH YELLOW LINE (SEE OPTION ITEMS)
STA A 346+97 - STA A 373+40 (SOLID LT + RT)

TEMPORARY 4 INCH YELLOW LINE
STA A 346+97 - STA A 373+40 (SOLID LT + RT)

SIGN LEGEND

R	=	REMOVE
S	=	SALVAGE
N	=	NEW
RET	=	RETAIN
T&T	=	THINNING & TRIMMING
B-B	=	BACK TO BACK
EXISTING		----------
NEW		————

0 50 100
SCALE IN FEET

PROJECT NAME: WARDSBORO-JAMAICA
PROJECT NUMBER: ER STP 013-1(17)

FILE NAME: d2b236_bdr.dgn
PROJECT LEADER: K. UPMAL
DESIGNED BY: B. KIPP
PLAN SHEET 31

PLOT DATE: 2/26/2014
DRAWN BY: B. KIPP
CHECKED BY: A. KEMPTON
SHEET 113 OF 444