STEEL BEAM GUARDRAIL, GALVANIZED W/ 8 FT POSTS
STA B 39+17 - STA B 50+12 LT

STEEL BEAM GUARDRAIL, GALVANIZED
STA B 50+12 - STA B 50+25 LT

ANCHOR FOR STEEL BEAM RAIL
STA B 50+16 LT

DELINEATOR WITH STEEL POSTS
STA B 50+25 LT

REMOVE AND DISPOSE OF GUARDRAIL
STA B 39+07 - STA 50+14 LT

STONE FILL, TYPE I
~~STA B 44+60 - STA B 50+00 LT~~
STA B 44+00 - STA B 49+95 LT

GRUBBING MATERIAL
STA B 44+60 - STA B 50+00 LT

GEOTEXTILE FOR SILT FENCE
STA B 44+60 - STA B 50+00 LT

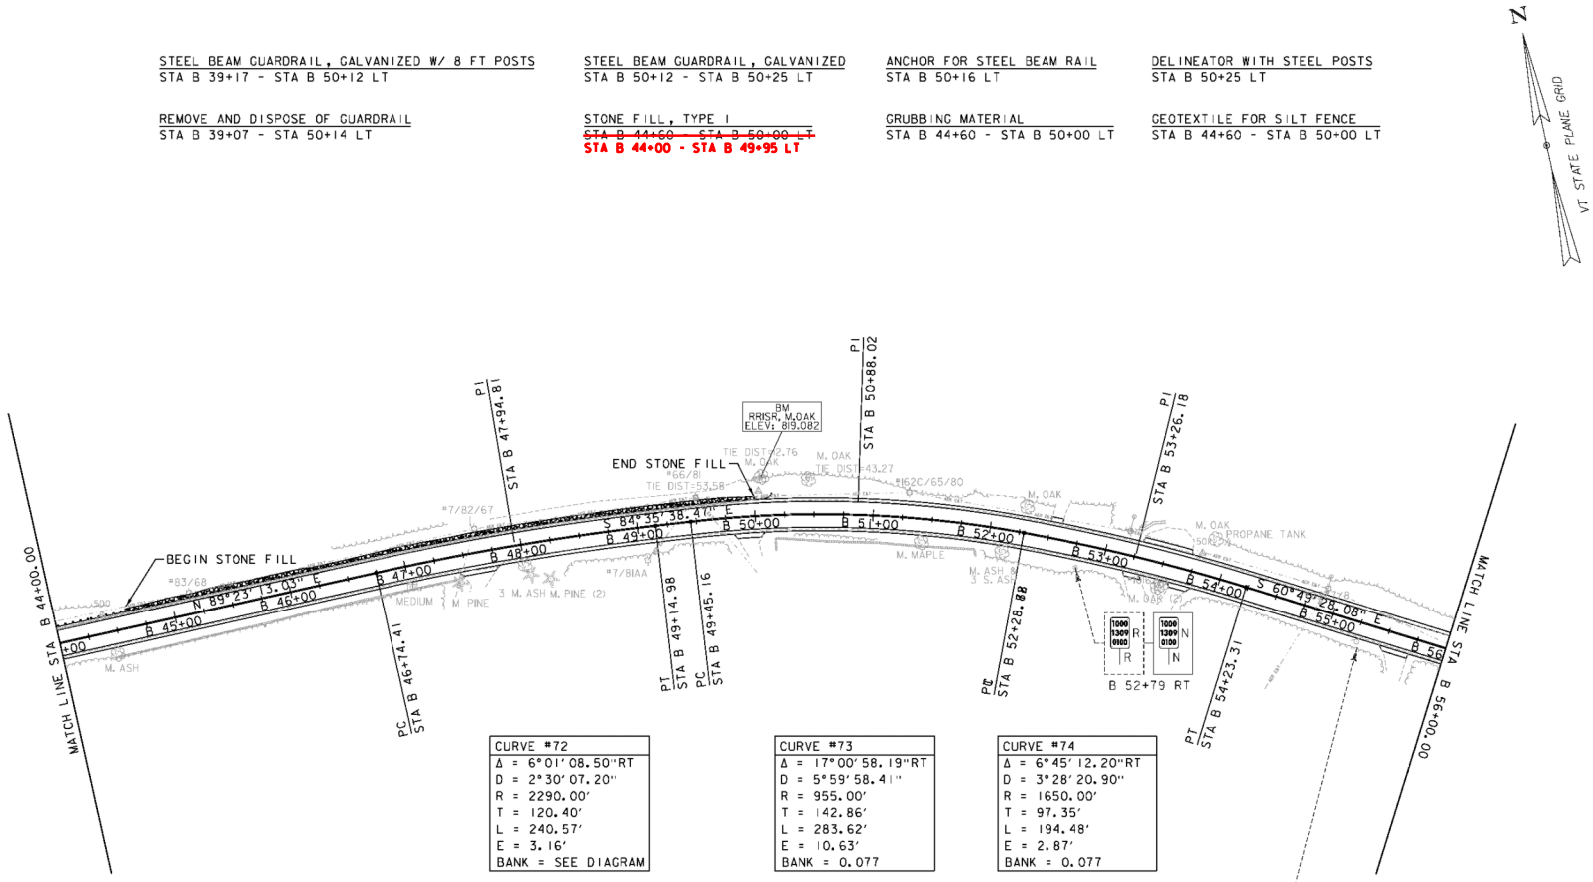

CURVE #72
Δ = 6°01'08.50"RT
D = 2°30'07.20"
R = 2290.00'
T = 120.40'
L = 240.57'
E = 3.16'
BANK = SEE DIAGRAM

CURVE #73
Δ = 17°00'58.19"RT
D = 5°59'58.41"
R = 955.00'
T = 142.86'
L = 283.62'
E = 10.63'
BANK = 0.077

CURVE #74
Δ = 6°45'12.20"RT
D = 3°28'20.90"
R = 1650.00'
T = 97.35'
L = 194.48'
E = 2.87'
BANK = 0.077

DURABLE 4 INCH WHITE LINE (SEE OPTION ITEMS)
STA A 373+69 - STA B 119+24 (SOLID LT)
STA A 346+96 - STA B 118+68 (SOLID RT)

DURABLE 4 INCH YELLOW LINE (SEE OPTION ITEMS)
STA A 373+76 - STA B 118+58 (SOLID LT + RT)

TEMPORARY 4 INCH WHITE LINE
STA A 373+69 - STA B 119+24 (SOLID LT)
STA A 346+96 - STA B 118+68 (SOLID RT)

TEMPORARY 4 INCH YELLOW LINE
STA A 373+76 - STA B 118+58 (SOLID LT + RT)

0 50 100
SCALE IN FEET

SIGN LEGEND

R	= REMOVE
S	= SALVAGE
N	= NEW
RET	= RETAIN
T&T	= THINNING & TRIMMING
B-B	= BACK TO BACK
EXISTING	----------
NEW	----------

PROJECT NAME:	WARDSBORO-JAMAICA
PROJECT NUMBER:	ER STP 013-1(17)
FILE NAME: d12b236_bdr.dgn	PLOT DATE: 2/26/2014
PROJECT LEADER: K. UPMAL	DRAWN BY: B. KIPP
DESIGNED BY: B. KIPP	CHECKED BY: A. KEMPTON
PLAN SHEET 37	SHEET 125 OF 444