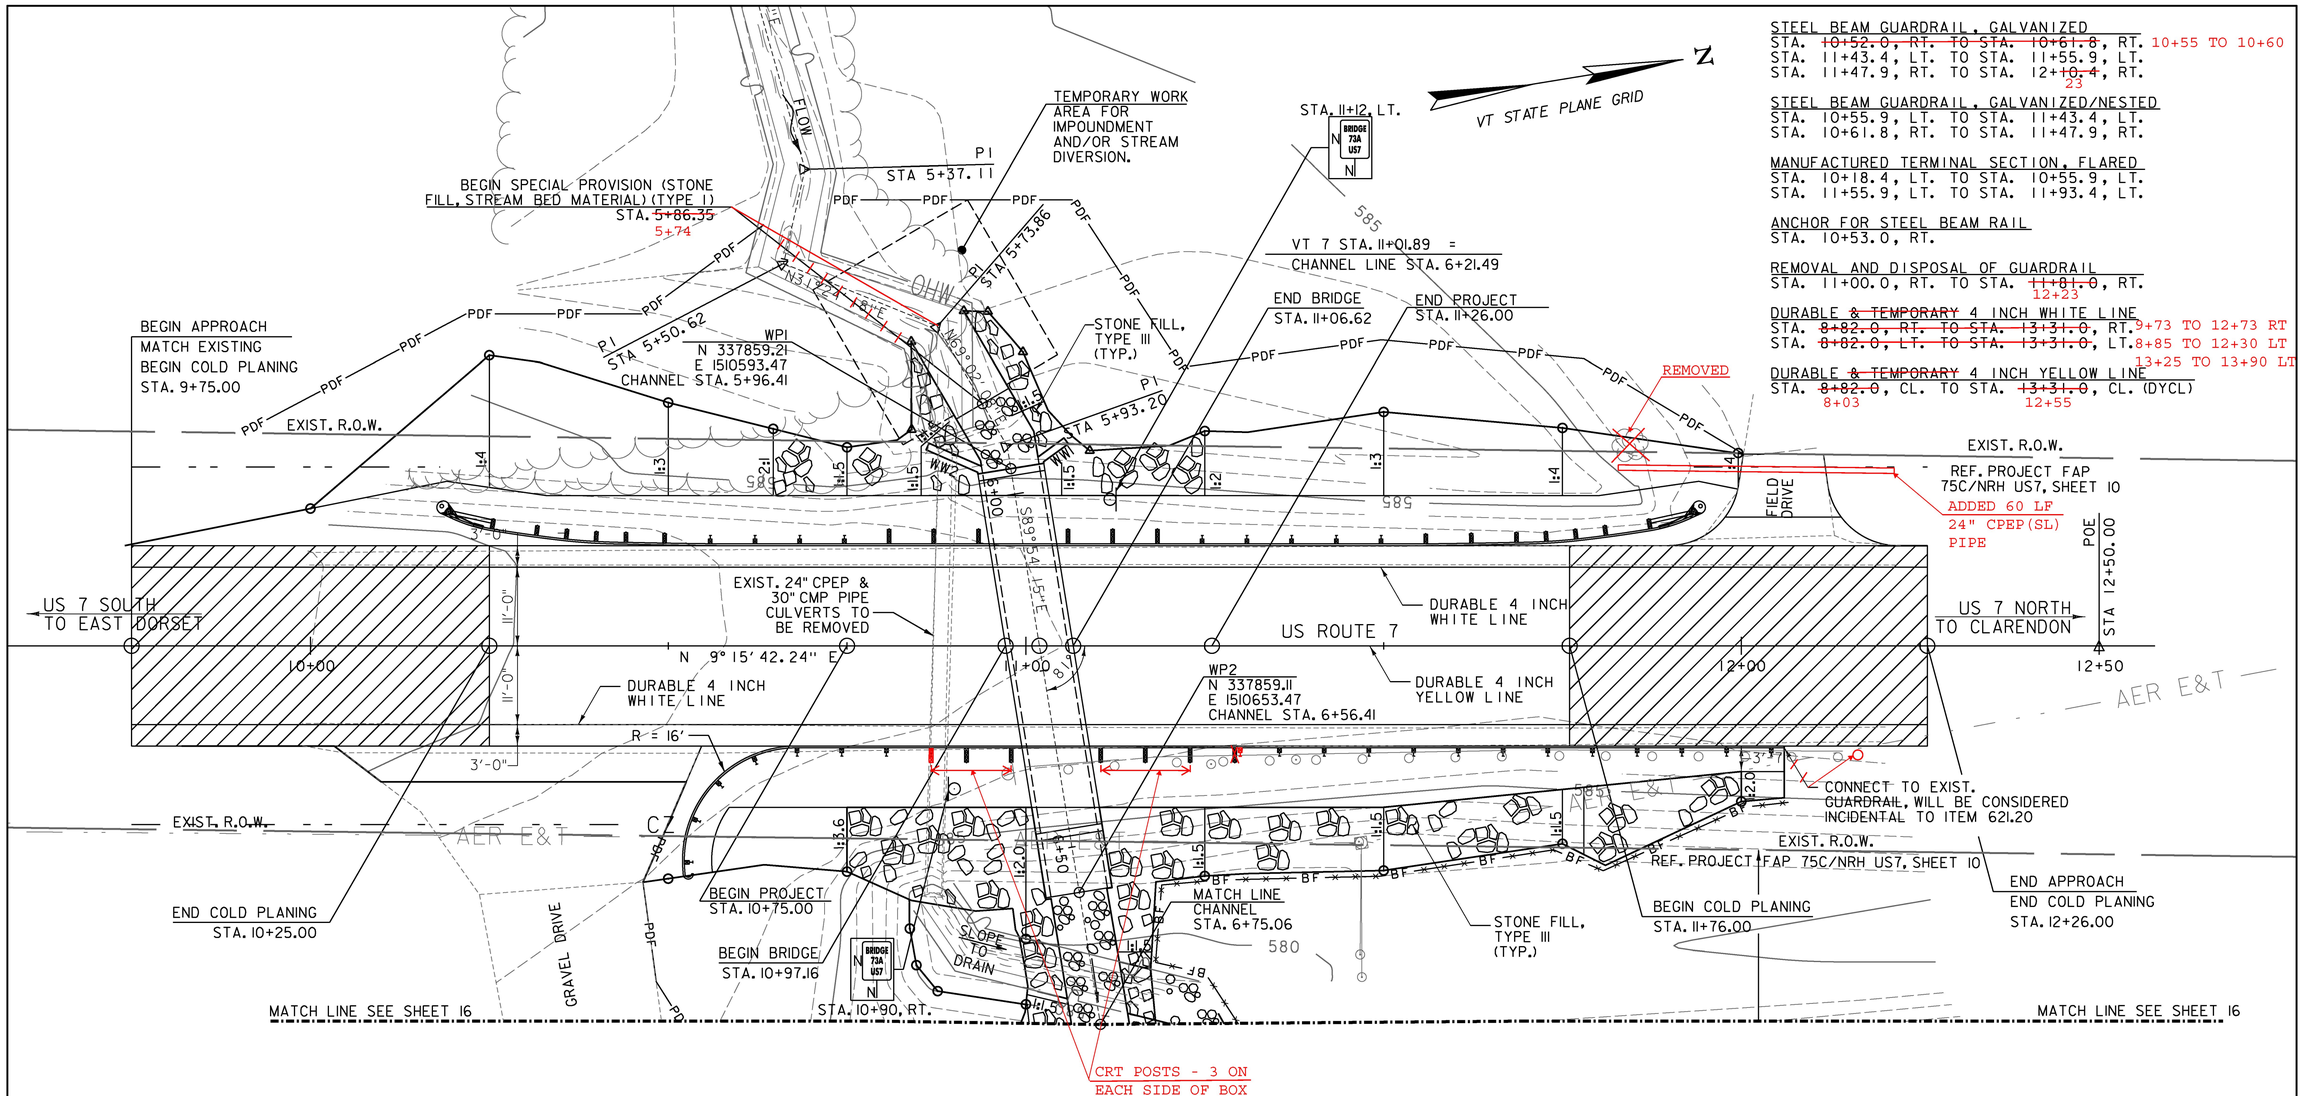

TRAFFIC SIGN SUMMARY

STATION	SIGN LEGEND	SIGN DIMENSIONS			NEW SIGNS		NEW SIGN POSTS						REMARKS	STD. SHEET NUMBER
		EA	WIDTH (in)	HEIGHT (in)	"A"	"B"	NO. OF POSTS	SQUARE STEEL (in) 1.75 lb/ft 1.88	2.0 2.42	2.5 3.35	ANCHOR	SLEEVE		
10+90, RT	BRIDGE 73A US 7	1	6	10	0.42		1	X			X		VR-701	T-42
11+12, LT	BRIDGE 73A US 7	1	6	10	0.42		1	X			X		VR-701	T-42
				TOTALS	SF 1.00	SF		FT 16						

FINAL POST LENGTHS ARE TO BE DETERMINED IN THE FIELD. POST SIZES ARE COMPUTED BASED ON INFORMATION FURNISHED ON THE STANDARD SHEETS AND THE VTRANS "SIGN POST DESIGN GUIDELINE."

LEGEND

STONE FILL, TYPE III

SPECIAL PROVISION (STONE FILL, STREAM BED MATERIAL) (TYPE I)

0 10 20

Stantec

PROJECT NAME: WALLINGFORD
PROJECT NUMBER: ER CULV(39)

FILE NAME: z12b380_LAYOUT.dgn
PROJECT LEADER: G. BOGUE
DESIGNED BY: T. KNIGHT
LAYOUT PLAN - BRIDGE NO. 73A

PLOT DATE: 6/16/2016
DRAWN BY: J. SOTER
CHECKED BY: T. KNIGHT
SHEET 10 OF 36