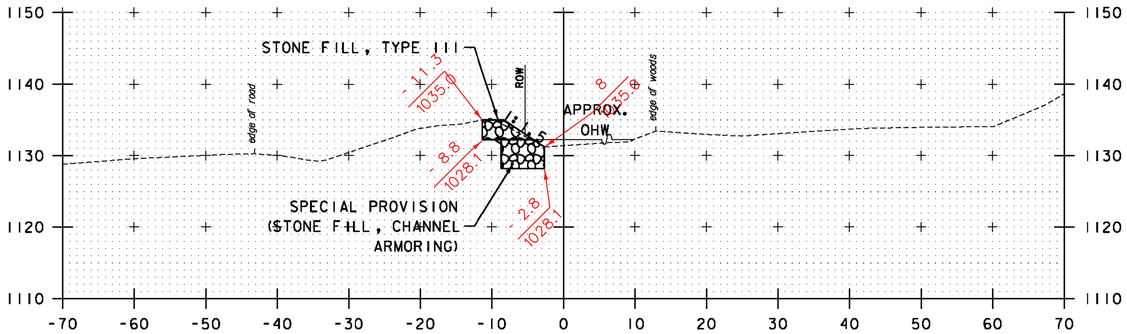

3+00

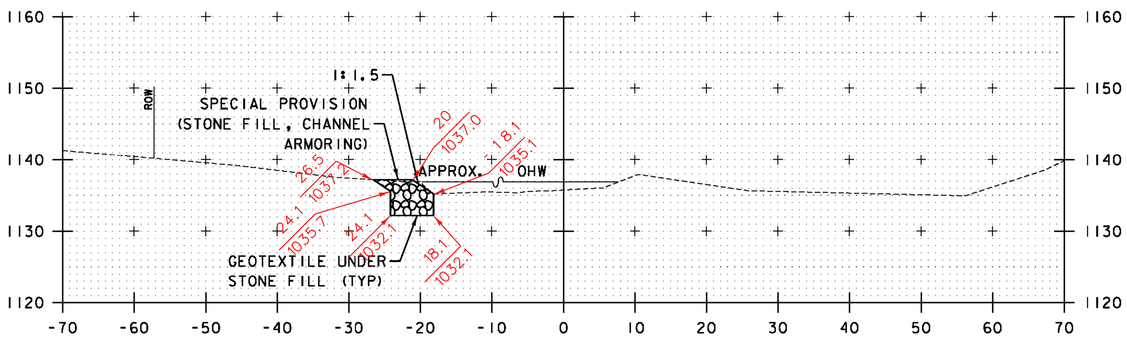

2+50

BEGIN CHANNEL WORK @ STA. 2+03.00

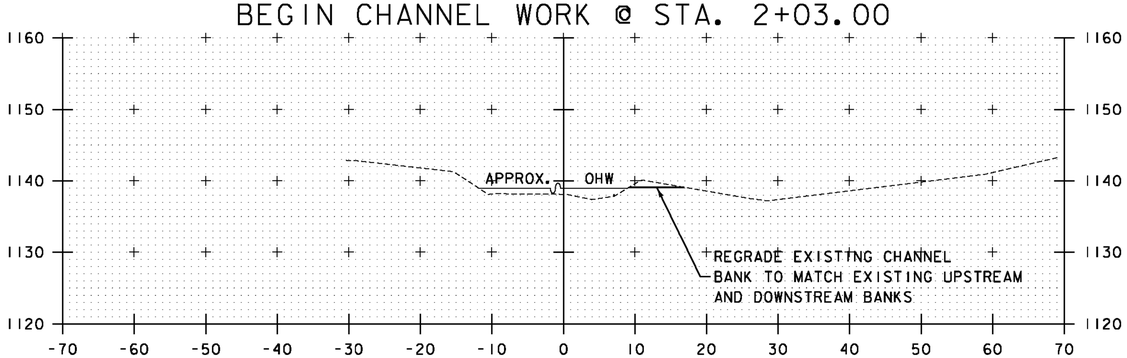

2+00

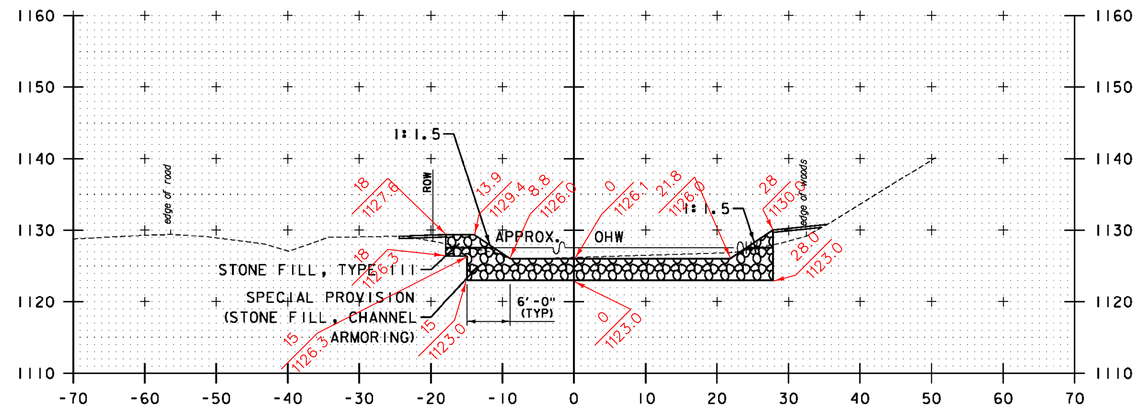

4+00

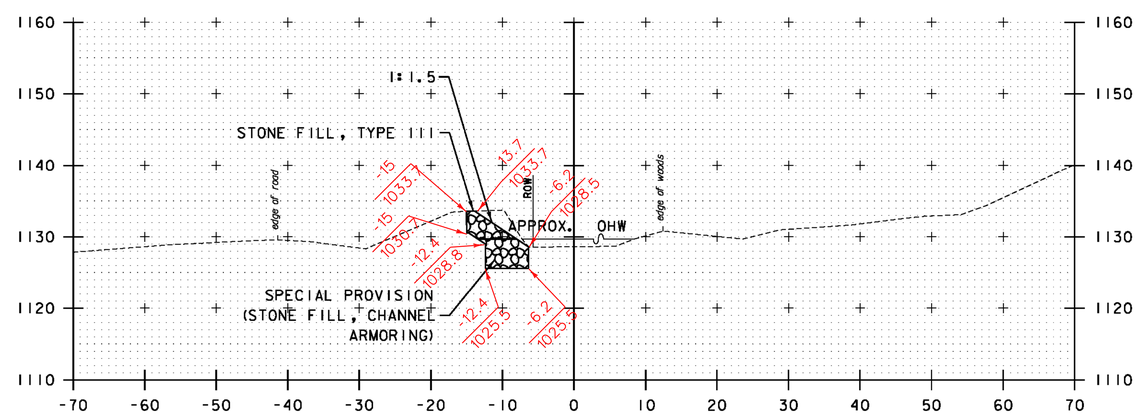

3+50

STA. 2+00 TO STA. 4+00

PROJECT NAME: JAMAICA	
PROJECT NUMBER: ER STP 013-2(12)	
FILE NAME: Z12B474xsl.dgn	PLOT DATE: 02/27/2015
PROJECT LEADER: E. ATKINS	DRAWN BY: C. MORIN
DESIGNED BY: T. BIGELOW	CHECKED BY: E. ATKINS
CROSS SECTION SHEET 4	SHEET 40 OF 48

GREEN INTERNATIONAL AFFILIATES, INC.
CIVIL AND STRUCTURAL ENGINEERS