DIRECTION	MILEPOINT	LOCATION CODE (SHEET 2)	SIGN CODE	WIDTH (IN)	HEIGHT (IN)	SHEETING REMARKS	SIGN LEGEND	NEW SIGNS "A"	NEW SIGNS "B"	EXISTING SIGNS RETAIN	EXISTING SIGNS SALVAGE FROM	EXISTING SIGNS SALVAGE TO	EXISTING SIGNS REMOVE	EXIST POST RETAIN	EXIST POST REMOVE	NUMBER OF NEW POSTS	SQUARE STEEL (IN) 1.75 (LB / FT) 1.88	SQUARE STEEL (IN) 2.00 (LB / FT) 2.42	SQUARE STEEL (IN) 2.50 (LB / FT) 3.35	TUBULAR STEEL Ø (IN) FOUNDATION	TUBULAR STEEL Ø (IN) 3.00 (LB / FT) 7.60	TUBULAR STEEL Ø (IN) 3.50 (LB / FT) 9.00	TUBULAR STEEL Ø (IN) 4.00 (LB / FT) 10.80	TUBULAR STEEL Ø (IN) 5.00 (LB / FT) 14.60	SIGN FRAME REQUIRED	REMARKS	SIGN DETAIL LOCATION SHSM	SIGN DETAIL LOCATION PROJECT SHEET #	SIGN DETAIL LOCATION STANDARD SHEET #
ALBURGH US-2 EB							FY-FLUORESCENT YELLOW FYG-FLUORESCENT YELLOW GREEN																			"SHSM"-STANDARD HIGHWAY SIGNS AND MARKINGS			
		A	W11-1	30	30								1																
		A	W11-1	30	30		11/10/14	6.25								1			16.75 X								X		
		A	W16-1P	18	24		04/15/15	3.00																			X		
EB	2.974	A	M2-1	21	15								1		X														
		A	M1-5A	24	24		11/10/14						1					13.25											
		A	M2-1	21	15	BLK/ WHT		2.19								1		X									X		
		A	M1-5	30	24	BLK/ WHT		5.00																			X		
EB	3.015	A	UNK.	UNK.	UNK.		EMPTY POST								X														
EB	3.045	A	VD-062BC	74.75	16		TRAVEL INFORMATION ^UP WELCOME CNTR. ON LEFT 3/10			1				X															
		A	VD-062C	74.75	16		C BOARD			1																			
EB	3.099	A	D1-1	72	10		D-BOARD ASSEMBLY						1		X														
		A	D1-1A	72	10		11/10/14						1																
		A	D1-1A	72	10								1					14.25 15.25											
		A	VD1-1	72	12		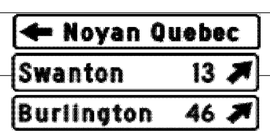	6.00								2		X									SLIP BASES		7	
		A	VD1-1	72	12			6.00																					7	
SIGN SUMMARY SHEET							SHEET TOTALS	28.44	0.00	2	0	0	6	0	0	4		59.5 60.0		0	0.0	0.0	0.0	0.0					
								SF	SF	EA	EA	EA	EA	EA	EA	EA		FT		EA	LB	LB	LB	LB					
VERMONT AGENCY OF TRANSPORTATION							TOWN DIRECTIONAL TOTALS	897.8	0.0	37	1	1	165	0	0	92		1380.0		0		0.0							

PROJECT NAME: ALBURGH-COLCHESTER
PROJECT NUMBER: STPG SIGN(45)
FILE NAME: 1 Alburah US2 EB TSS.xls
PROJECT MANAGER: D. BRYANT
DESIGNED BY: B. TOOTHAKER
ALBURGH EB SHEET 5
PLOT DATE: 4/15/2014
DRAWN BY: J. BLANCHARD
CHECKED K. KERN
SHEET 19 OF 167