DIRECTION	MILEPOINT	LOCATION CODE (SHEET 2)	SIGN CODE	WIDTH (IN)	HEIGHT (IN)	SHEETING REMARKS	SIGN LEGEND	NEW SIGNS "A"	NEW SIGNS "B"	EXISTING SIGNS RETAIN	EXISTING SIGNS SALVAGE FROM	EXISTING SIGNS SALVAGE TO	EXISTING SIGNS REMOVE	EXIST POST RETAIN	EXIST POST REMOVE	NUMBER OF NEW POSTS	SQUARE STEEL (IN) 1.75 (LB/FT) 1.88	SQUARE STEEL (IN) 2.00 (LB/FT) 2.42	SQUARE STEEL (IN) 2.50 (LB/FT) 3.35	TUBULAR STEEL Ø (IN) FOUNDATION	TUBULAR STEEL Ø (IN) 3.00 (LB/FT) 7.60	TUBULAR STEEL Ø (IN) 3.50 (LB/FT) 9.00	TUBULAR STEEL Ø (IN) 4.00 (LB/FT) 10.80	TUBULAR STEEL Ø (IN) 5.00 (LB/FT) 14.60	SIGN FRAME REQUIRED	REMARKS	SIGN DETAIL LOCATION SHSM	SIGN DETAIL LOCATION PROJECT SHEET #	SIGN DETAIL LOCATION STANDARD SHEET #
ALBURGH US-2 EB							FY-FLUORESCENT YELLOW FYG-FLUORESCENT YELLOW GREEN																				"SHSM"-STANDARD HIGHWAY SIGNS AND MARKINGS			
		A	W16-7	24	12								1																
		A	S1-1	36	36	FYG	11/14/14	9.00								1			14.00 X							REQUIRES VEGETATION CLEARING	X		
		A	W16-7PL	24	12	FYG		2.00																			X		
EB	3.912	A	W11-8	30	30		11/10/14						1		X			13.75											
		A	W11-8	30	30			6.25									1		X									X		
EB	3.955	A	S5-2	24	30								1		X														
		A	R2-1	24	30		11/14/14						1						15.50										
		A	R2-1	24	30			5.00								1			X								X		
		A	S5-2	24	30			5.00																			X		
EB	4.022	D	VR-017	24	30		11/10/14						1	X				13.00											
		C	VR-017	24	30			5.00																			FIREHOUSE RD (TH-24)		10	
EB	4.030	D	R1-1	30	30								1	~~X~~															
		D	R1-1	30	30		11/10/14	6.25										16.00									FIREHOUSE RD (TH-24)	X		
EB	4.030	A/B	D3-1	54	12		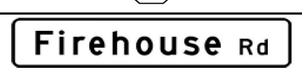 11/10/14	4.50								2		11.50 X 12.00									FIREHOUSE RD (TH-24); FIELD LOCATE FOR VISIBILITY FROM ROUTE 2		12	
EB	4.062	A	W11-2	30	30		11/10/14						1	X															
SIGN SUMMARY SHEET							SHEET TOTALS	43.00	0.00	0	0	0	7	0	0	5		~~111.50~~ ~~75.0~~			0	0.0	0.0	0.0	0.0				
								SF	SF	EA	EA	EA	EA	EA	EA	EA		FT			EA	LB	LB	LB	LB				
VERMONT AGENCY OF TRANSPORTATION							TOWN DIRECTIONAL TOTALS	897.8	0.0	37	1	1	165	0	0	92		1380.0			0	0.0							

PROJECT NAME: **ALBURGH-COLCHESTER**
PROJECT NUMBER: **STPG SIGN(45)**
FILE NAME: **1 Alburgh US2 EB TSS.xls** PLOT DATE: **4/15/2014**
PROJECT MANAGER: **D. BRYANT** DRAWN BY: **J. BLANCHARD**
DESIGNED BY: **B. TOOTHAKER** CHECKED **K. KERN**
ALBURGH EB SHEET 10 SHEET **24** OF **167**