DIRECTION	MILEPOINT	LOCATION CODE (SHEET 2)	SIGN CODE	WIDTH (IN)	HEIGHT (IN)	SHEETING REMARKS	SIGN LEGEND	NEW SIGNS "A"	NEW SIGNS "B"	EXISTING SIGNS RETAIN	EXISTING SIGNS SALVAGE FROM	EXISTING SIGNS SALVAGE TO	EXISTING SIGNS REMOVE	EXIST POST RETAIN	EXIST POST REMOVE	NUMBER OF NEW POSTS	SQUARE STEEL (IN) 1.75 (LB/FT) 1.88	SQUARE STEEL (IN) 2.00 (LB/FT) 2.42	SQUARE STEEL (IN) 2.50 (LB/FT) 3.35	TUBULAR STEEL Ø (IN) FOUNDATION	TUBULAR STEEL Ø (IN) 3.00 (LB/FT) 7.60	TUBULAR STEEL Ø (IN) 3.50 (LB/FT) 9.00	TUBULAR STEEL Ø (IN) 4.00 (LB/FT) 10.80	TUBULAR STEEL Ø (IN) 5.00 (LB/FT) 14.60	SIGN FRAME REQUIRED	REMARKS	SIGN DETAIL LOCATION SHSM	SIGN DETAIL LOCATION PROJECT SHEET #	SIGN DETAIL LOCATION STANDARD SHEET #
ALBURGH US-2 EB							FY-FLUORESCENT YELLOW FYG-FLUORESCENT YELLOW GREEN																			"SHSM"-STANDARD HIGHWAY SIGNS AND MARKINGS			
		A	R8-3A	24	30		NO PARKING DEC. 1 - APR. 1 MIDNIGHT TO 7AM			1																			
EB	4.891	A	W1-8L	18	24		11/11/14	3.00								1		13.00 X								INSTALL 95 FT EAST OF END NO PARKING SIGN	X		
		B	W1-8R	18	24			3.00																			X		
EB	5.018	A	R2-1	24	30								1	~~X~~															
		A	R2-1	24	30		11/11/14	5.00																			X		
EB	5.171	A	R2-1	24	30								1	~~X~~															
		A	R2-1	24	30		11/11/14	5.00										16.00									X		
EB	5.313	A	R2-1	24	30								1	~~X~~															
		A	R2-1	24	30		11/11/14	5.00																			X		
EB	5.574	A	W1-2R	30	30		04/11/15	6.25								1		17.25 X								INSTALL 100 FT WEST OF BEGINNING OF CURVE (500 FT WEST OF CENTERLINE OF HAYLDE RD)	X		
EB	5.661	C	VR-017	24	30								1	~~X~~															
		C	R2-1	24	30		SPEED LIMIT 25			1																			
		C	VR-017	24	30		11/11/14	5.00										15.00								HAYLDE RD (TH-27)		10	
EB	5.667	D	R1-1	30	30								1		X			14.25											
		A/B	D3-1	42	12		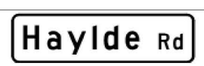 11/11/14	3.50								1		X								HAYLDE RD (TH-27); MOUNT TO STOP SIGN WITH BRACKETS		12	
							SHEET TOTALS	35.75	0.00	2	0	0	5	0	0	3		~~75.50~~ 45.0		0	0.0	0.0	0.0	0.0				
								SF	SF	EA	EA	EA	EA	EA	EA	EA		FT		EA	LB	LB	LB	LB				
							TOWN DIRECTIONAL TOTALS	897.8	0.0	37	1	1	165	0	0	92		1380.0		0		0.0						

SIGN SUMMARY SHEET

VERMONT AGENCY OF TRANSPORTATION

PROJECT NAME: **ALBURGH-COLCHESTER**
PROJECT NUMBER: **STPG SIGN(45)**
FILE NAME: **1 Alburgh US2 EB TSS.xls**
PROJECT MANAGER: **D. BRYANT**
DESIGNED BY: **B. TOOTHAKER**
ALBURGH EB SHEET 15
PLOT DATE: **4/15/2014**
DRAWN BY: **J. BLANCHARD**
CHECKED **K. KERN**
SHEET **29** OF **167**