DIRECTION	MILEPOINT	LOCATION CODE (SHEET 2)	SIGN CODE	WIDTH (IN)	HEIGHT (IN)	SHEETING REMARKS	SIGN LEGEND	NEW SIGNS "A"	NEW SIGNS "B"	EXISTING SIGNS RETAIN	EXISTING SIGNS SALVAGE FROM	EXISTING SIGNS SALVAGE TO	EXISTING SIGNS REMOVE	EXIST POST RETAIN	EXIST POST REMOVE	NUMBER OF NEW POSTS	SQUARE STEEL (IN) 1.75 (LB/FT) 1.88	SQUARE STEEL (IN) 2.00 (LB/FT) 2.42	SQUARE STEEL (IN) 2.50 (LB/FT) 3.35	FOUNDATION	TUBULAR STEEL Ø (IN) 3.00 (LB/FT) 7.60	TUBULAR STEEL Ø (IN) 3.50 (LB/FT) 9.00	TUBULAR STEEL Ø (IN) 4.00 (LB/FT) 10.80	TUBULAR STEEL Ø (IN) 5.00 (LB/FT) 14.60	SIGN FRAME REQUIRED	REMARKS	SIGN DETAIL LOCATION SHSM	SIGN DETAIL LOCATION PROJECT SHEET #	SIGN DETAIL LOCATION STANDARD SHEET #
NORTH HERO US-2 EB							FY-FLUORESCENT YELLOW FYG-FLUORESCENT YELLOW GREEN																				"SHSM"-STANDARD HIGHWAY SIGNS AND MARKINGS			
EB	5.788	A	W16-7	24	12								1	X															
		A	W11-2	30	30								1																
		A	R1-6	12	36		YIELD TO PEDESTRIANS IN CROSSWALK 12/03/14				1		1														SALVAGE AND RETURN TO TOWN			
		A	W11-2	30	30	FYG		6.25																				X		
		A	W16-7P	24	12	FYG		2.00																				X		
EB	5.944	A	R2-1	24	30								1	X															
		A	R2-1	24	30		12/03/14	5.00																				X		
EB	6.115	A	R2-1	24	30		12/04/14						1	X															
		A	R2-1	24	30			5.00																				X		
EB	6.183	A	VD-062AS	72	16		BUSINESS SIGN 12/04/14			1				X															
EB	6.221	C	VR-017	24	30		12/04/14						1	X															
		C	VR-017	24	30			5.00																				STATION RD (TH-2)		10	
EB	6.228	D	R1-1	30	30		12/04/14						1	X															
		A/B	D3-1	UNK	12		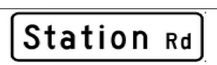						1																	
		A/B	D3-1	42	12			3.50																				STATION RD (TH-2); MOUNT ON STOP SIGN WITH BRACKET		13	
SIGN SUMMARY SHEET							SHEET TOTALS	26.75	0.00	1	1	0	8	0	0	0		0.0		0	0.0	0.0	0.0	0.0					
								SF	SF	EA	EA	EA	EA	EA	EA	EA		FT		EA	LB	LB	LB	LB					
VERMONT AGENCY OF TRANSPORTATION							TOWN DIRECTIONAL TOTALS	320.7	0.0	8	1	0	57	0	0	30		450.0		0		0.0							

PROJECT NAME: **ALBURGH-COLCHESTER**
PROJECT NUMBER: **STPG SIGN(45)**

FILE NAME: **3 NORTH HERO US2 EB TSS.xls** PLOT DATE: **3/14/2014**
PROJECT MANAGER: **D. BRYANT** DRAWN BY: **J. BLANCHARD**
DESIGNED BY: **B. TOOTHAKER** CHECKED **K. KERN**
NORTH HERO EB SHEET 6 SHEET **72** OF **167**