DIRECTION	MILEPOINT	LOCATION CODE (SHEET 2)	SIGN CODE	WIDTH (IN)	HEIGHT (IN)	SHEETING REMARKS	SIGN LEGEND	NEW SIGNS "A"	NEW SIGNS "B"	EXISTING SIGNS RETAIN	EXISTING SIGNS SALVAGE FROM	EXISTING SIGNS SALVAGE TO	EXISTING SIGNS REMOVE	EXIST POST RETAIN	EXIST POST REMOVE	NUMBER OF NEW POSTS	SQUARE STEEL (IN) 1.75 (LB / FT) 1.88	SQUARE STEEL (IN) 2.00 (LB / FT) 2.42	SQUARE STEEL (IN) 2.50 (LB / FT) 3.35	TUBULAR STEEL Ø (IN) FOUNDATION	TUBULAR STEEL Ø (IN) 3.00 (LB / FT) 7.60	TUBULAR STEEL Ø (IN) 3.50 (LB / FT) 9.00	TUBULAR STEEL Ø (IN) 4.00 (LB / FT) 10.80	TUBULAR STEEL Ø (IN) 5.00 (LB / FT) 14.60	SIGN FRAME REQUIRED	REMARKS	SIGN DETAIL LOCATION SHSM	SIGN DETAIL LOCATION PROJECT SHEET #	SIGN DETAIL LOCATION STANDARD SHEET #
GRAND ISLE US-2 WB							FY-FLUORESCENT YELLOW FYG-FLUORESCENT YELLOW GREEN																			"SHSM"-STANDARD HIGHWAY SIGNS AND MARKINGS			
		F	D1-1A	72	10								1																
		F	D1-1A	72	10								1																
		F	VD1-1	72	12		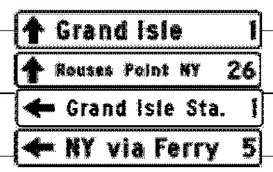	6.00								2			11.75 X 12.00						SLIP BASES		8	
		F	VD1-1	72	12			6.00																				8	
		F	VD1-1	72	12			6.00																				8	
		F	VD1-1	72	12		04/24/15	6.00																				8	
WB	4.516	F	M3-3	24	12		ROUTE MARKER ASSEMBLY						1		X														
		F	M1-5	30	24								1																
		F	M6-1	21	15								1																
		F	M3-4	24	12								1																
		F	M1-4	24	24								1																
		F	M6-3	21	15								1																
		F	M3-3	24	12	GRN/ WHT		2.00								2			11.50 X 11.50						#2	SLIP BASES	X		
		F	M1-5	24	30	GRN/ WHT		5.00																			X		
		F	M6-1L	21	15	GRN/ WHT		2.19																			X		
SIGN SUMMARY SHEET							SHEET TOTALS	33.19	0.00	0	0	0	8	0	0	4		46.75 ~~50.0~~		0	0.0	0.0	0.0	0.0					
								SF	SF	EA	EA	EA	EA	EA	EA	EA		FT		EA	LB	LB	LB	LB					
VERMONT AGENCY OF TRANSPORTATION							TOWN DIRECTIONAL TOTALS	409.7	0.0	14	0	0	69	0	0	51		765.0		0		0.0							

PROJECT NAME: ALBURGH-COLCHESTER
PROJECT NUMBER: STPG SIGN(45)
FILE NAME: 6 GRAND ISLE US2 WB TSS.xls
PLOT DATE: 4/28/2014
PROJECT MANAGER: D. BRYANT
DRAWN BY: J. BLANCHARD
DESIGNED BY: B. TOOTHAKER
CHECKED: K. KERN
GRAND ISLE WB SHEET 3
SHEET 98 OF 167