DIRECTION	MILEPOINT	LOCATION CODE (SHEET 2)	SIGN CODE	WIDTH (IN)	HEIGHT (IN)	SHEETING REMARKS	SIGN LEGEND	NEW SIGNS "A"	NEW SIGNS "B"	EXISTING SIGNS RETAIN	EXISTING SIGNS SALVAGE FROM	EXISTING SIGNS SALVAGE TO	EXISTING SIGNS REMOVE	EXIST POST RETAIN	EXIST POST REMOVE	NUMBER OF NEW POSTS	SQUARE STEEL (IN) 1.75 (LB/FT) 1.88	SQUARE STEEL (IN) 2.00 (LB/FT) 2.42	SQUARE STEEL (IN) 2.50 (LB/FT) 3.35	TUBULAR STEEL Ø (IN) FOUNDATION	TUBULAR STEEL Ø (IN) 3.00 (LB/FT) 7.60	TUBULAR STEEL Ø (IN) 3.50 (LB/FT) 9.00	TUBULAR STEEL Ø (IN) 4.00 (LB/FT) 10.80	TUBULAR STEEL Ø (IN) 5.00 (LB/FT) 14.60	SIGN FRAME REQUIRED	REMARKS	SIGN DETAIL LOCATION SHSM	SIGN DETAIL LOCATION PROJECT SHEET #	SIGN DETAIL LOCATION STANDARD SHEET #
GRAND ISLE US-2 WB							FY-FLUORESCENT YELLOW FYG-FLUORESCENT YELLOW GREEN																			"SHSM"-STANDARD HIGHWAY SIGNS AND MARKINGS			
WB	1.873	F	VD-062B	72	16		BUSINESS SIGN			1				X															
		F	VD-062B	72	16		BUSINESS SIGN			1																			
		F	VD-062B	72	16		BUSINESS SIGN			1																			
WB	1.850	F	VW-544	36	36								1		X			12.75											
		F	W13-1	24	24								1					12.75											
		F	VW-544	36	36		04/21/15	9.00								2		X								SLIP BASES			E-154
		F	W13-1P	24	24			4.00																				X		
WB	1.796	E/F	D3-1	UNK.	UNK.		12/01/14						1		X			14.00									FAYWOOD RD (TH-9)			
		G/H	D3-1	42	12			3.50								2		14.00 X									FAYWOOD RD (TH-9); MOUNT TO STREET NAME SIGN WITH BRACKET		13	
		E/F	D3-1	60	12		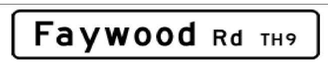	5.00																			FAYWOOD RD (TH-9); FIELD LOCATE FOR VISIBILITY FROM ROUTE 2		14	
WB	1.795	G	VR-017	24	30			5.00																			FAYWOOD RD (TH-9)		10	
WB	1.795	H	R1-1	30	30		12/01/14						1	X															
		H	R1-1	30	30			6.25																			FAYWOOD RD (TH-9); INSTALL RED REFLECTIVE SHEETING ON POST (SEE MUTCD 2A.15 & 2A.21)	X		
WB	1.788	H	R1-1	30	30		12/01/14						1	X													REQUIRES VEGETATION CLEARING			
		H	R1-1	30	30			6.25																			FAYWOOD RD (TH-9); INSTALL REFLECTIVE SHEETING ON POST (SEE MUTCD 2A.15 & 2A.21)	X		
SIGN SUMMARY SHEET							SHEET TOTALS	39.00	0.00	3	0	0	5	0	0	4		53.50 ~~60.0~~		0	0.0	0.0	0.0	0.0					
								SF	SF	EA	EA	EA	EA	EA	EA	EA		FT		EA	LB	LB	LB	LB					
VERMONT AGENCY OF TRANSPORTATION							TOWN DIRECTIONAL TOTALS	409.7	0.0	14	0	0	69	0	0	51		765.0		0	0.0								

PROJECT NAME: ALBURGH-COLCHESTER
PROJECT NUMBER: STPG SIGN(45)

FILE NAME: 6 GRAND ISLE US2 WB TSS.xls
PROJECT MANAGER: D. BRYANT
DESIGNED BY: B. TOOTHAKER
GRAND ISLE WB SHEET 9

PLOT DATE: 4/28/2014
DRAWN BY: J. BLANCHARD
CHECKED K. KERN