DIRECTION	MILEPOINT	LOCATION CODE (SHEET 2)	SIGN CODE	WIDTH (IN)	HEIGHT (IN)	SHEETING REMARKS	SIGN LEGEND	NEW SIGNS "A"	NEW SIGNS "B"	EXISTING SIGNS RETAIN	EXISTING SIGNS SALVAGE FROM	EXISTING SIGNS SALVAGE TO	EXISTING SIGNS REMOVE	EXIST POST RETAIN	EXIST POST REMOVE	NUMBER OF NEW POSTS	SQUARE STEEL (IN) 1.75 (LB/FT) 1.88	SQUARE STEEL (IN) 2.00 (LB/FT) 2.42	SQUARE STEEL (IN) 2.50 (LB/FT) 3.35	TUBULAR STEEL Ø (IN) FOUNDATION	TUBULAR STEEL Ø (IN) 3.00 (LB/FT) 7.60	TUBULAR STEEL Ø (IN) 3.50 (LB/FT) 9.00	TUBULAR STEEL Ø (IN) 4.00 (LB/FT) 10.80	TUBULAR STEEL Ø (IN) 5.00 (LB/FT) 14.60	SIGN FRAME REQUIRED	REMARKS	SIGN DETAIL LOCATION SHSM	SIGN DETAIL LOCATION PROJECT SHEET #	SIGN DETAIL LOCATION STANDARD SHEET #
SOUTH HERO US-2 EB							FY-FLUORESCENT YELLOW FYG-FLUORESCENT YELLOW GREEN																				"SHSM"-STANDARD HIGHWAY SIGNS AND MARKINGS			
		A	W16-9P	24	12								1																
		A	W11-2	30	30	FYG	11/18/14	6.25								1		14.50										X		
		A	W16-9P	24	12	FYG		2.00																				X		
EB	3.036	A	D1-1E	72	10		11/18/14						1	X				10.50 10.50												
		A	VD1-1	72	12		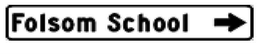	6.00								2													8	
EB	3.053	A	R8-3A	24	24		NO PARKING SYMBOL			1				X															
		A	VR-644P	24	12		BEGIN PARKING			1																			
EB	3.070	A	W16-7	24	12								1	X															
		A	W11-2	30	30		PEDESTRIAN SYMBOL 11/18/14						1																	
		A	S2-1	30	30	FYG		6.25																				X		
		A	W16-7PL	24	12	FYG		2.00																				X		
EB	3.075	C	VR-017	24	30		11/18/14						1		X			12.50												
		C	VR-017	24	30			5.00								1		X									SOUTH ST (TH-2)		10	
EB	3.085	D	R1-1	30	30		11/18/14						1	~~X~~				13.00												
		A/B	D3-1	UNK.	UNK.								1																	
SIGN SUMMARY SHEET							SHEET TOTALS	27.50	0.00	2	0	0	7	0	0	1		~~61.00~~ 15.0		0	0.0	0.0	0.0	0.0					
								SF	SF	EA	EA	EA	EA	EA	EA	EA		FT		EA	LB	LB	LB	LB					
VERMONT AGENCY OF TRANSPORTATION							TOWN DIRECTIONAL TOTALS	257.0	0.0	48	9	9	57	0	0	29		435.0		0	0.0								

PROJECT NAME: ALBURGH-COLCHESTER
PROJECT NUMBER: STPG SIGN(45)

FILE NAME: 7 SOUTH HERO US2 EB TSS.xls PLOT DATE: 3/14/2014
PROJECT MANAGER: D. BRYANT DRAWN BY: J. BLANCHARD
DESIGNED BY: B. TOOTHAKER CHECKED K. KERN
SOUTH HERO EB SHEET 6 SHEET 112 OF 167