DIRECTION	MILEPOINT	LOCATION CODE (SHEET 2)	SIGN CODE	WIDTH (IN)	HEIGHT (IN)	SHEETING REMARKS	SIGN LEGEND	NEW SIGNS "A"	NEW SIGNS "B"	EXISTING SIGNS RETAIN	EXISTING SIGNS SALVAGE FROM	EXISTING SIGNS SALVAGE TO	EXISTING SIGNS REMOVE	EXIST POST RETAIN	EXIST POST REMOVE	NUMBER OF NEW POSTS	SQUARE STEEL (IN) 1.75 (LB/FT) 1.88	SQUARE STEEL (IN) 2.00 (LB/FT) 2.42	SQUARE STEEL (IN) 2.50 (LB/FT) 3.35	TUBULAR STEEL Ø (IN) FOUNDATION	TUBULAR STEEL Ø (IN) 3.00 (LB/FT) 7.60	TUBULAR STEEL Ø (IN) 3.50 (LB/FT) 9.00	TUBULAR STEEL Ø (IN) 4.00 (LB/FT) 10.80	TUBULAR STEEL Ø (IN) 5.00 (LB/FT) 14.60	SIGN FRAME REQUIRED	REMARKS	SIGN DETAIL LOCATION SHSM	SIGN DETAIL LOCATION PROJECT SHEET #	SIGN DETAIL LOCATION STANDARD SHEET #
SOUTH HERO US-2 WB							FY-FLUORESCENT YELLOW FYG-FLUORESCENT YELLOW GREEN																				"SHSM"-STANDARD HIGHWAY SIGNS AND MARKINGS			
		F	VD-062B	72	16		BUSINESS SIGN			1																			
		F	VD-062AL	72	16		BUSINESS SIGN			1																			
WB	1.530	F	VD-062B	72	16		BUSINESS SIGN			1				X															
WB	1.510	F	VW-258	24	18								1		X														
		F	W11-2	30	30								1																
		F	W11-2	30	30	FYG		6.25								1			14.00 X								X		
		F	VW-258	24	18	FYG		3.00																					E-154
WB	1.484	G	VR-017	24	30								1		X														
		G	VR-017	24	30		11/21/14	5.00								1		14.50 X								KEEELER BAY RD (TH-9)		10	
WB	1.481	F	R2-1	24	30								1	X															
		F	R2-1	24	30			5.00																				X		
WB	1.481	H	R1-1	24	24								1		X														
		E/F	D3-1	UNK.	UNK.		KEELER BAY RD 11/21/14						1																
		H	R1-1	30	30			6.25								1		13.00 X								KEELER BAY RD (TH-9)	X		
WB	1.481	F	D3-1	58	12		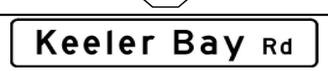 11/21/14	4.83								2		12.00 X 12.75								KEELER BAY RD (TH-9); FIELD LOCATE FOR VISIBILITY FROM ROUTE 2		14	
							SHEET TOTALS	30.33	0.00	3	0	0	6	0	0	5		66.25 ~~75.0~~		0	0.0	0.0	0.0	0.0					
								SF	SF	EA	EA	EA	EA	EA	EA	EA		FT		EA	LB	LB	LB	LB					
							TOWN DIRECTIONAL TOTALS	317.9	0.0	56	1	1	56	0	0	39		585.0		0		0.0							

SIGN SUMMARY SHEET

VERMONT AGENCY OF TRANSPORTATION

PROJECT NAME: **ALBURGH-COLCHESTER**
PROJECT NUMBER: **STPG SIGN(45)**
FILE NAME: **8 SOUTH HERO US2 WB TSS.x** PLOT DATE: **3/14/2014**
PROJECT MANAGER: **D. BRYANT** DRAWN BY: **J. BLANCHARD**
DESIGNED BY: **B. TOOTHAKER** CHECKED **K. KERN**
SOUTH HERO WB SHEET 9 SHEET **126** OF **167**