DIRECTION	MILEPOINT	LOCATION CODE (SHEET 2)	SIGN CODE	WIDTH (IN)	HEIGHT (IN)	SHEETING REMARKS	SIGN LEGEND	NEW SIGNS "A"	NEW SIGNS "B"	EXISTING SIGNS RETAIN	EXISTING SIGNS SALVAGE FROM	EXISTING SIGNS SALVAGE TO	EXISTING SIGNS REMOVE	EXIST POST RETAIN	EXIST POST REMOVE	NUMBER OF NEW POSTS	SQUARE STEEL (IN) 1.75 (LB / FT) 1.88	SQUARE STEEL (IN) 2.00 (LB / FT) 2.42	SQUARE STEEL (IN) 2.50 (LB / FT) 3.35	TUBULAR STEEL Ø (IN) FOUNDATION	TUBULAR STEEL Ø (IN) 3.00 (LB / FT) 7.60	TUBULAR STEEL Ø (IN) 3.50 (LB / FT) 9.00	TUBULAR STEEL Ø (IN) 4.00 (LB / FT) 10.80	TUBULAR STEEL Ø (IN) 5.00 (LB / FT) 14.60	SIGN FRAME REQUIRED	REMARKS	SIGN DETAIL LOCATION SHSM	SIGN DETAIL LOCATION PROJECT SHEET #	SIGN DETAIL LOCATION STANDARD SHEET #
SOUTH HERO US-2 WB							FY-FLUORESCENT YELLOW FYG-FLUORESCENT YELLOW GREEN																			"SHSM"-STANDARD HIGHWAY SIGNS AND MARKINGS			
WB	0.917	F	R2-1	24	30								1		X			14.50											
		F	R2-1	24	30		11/21/14	5.00								1		X									X		
WB	0.602	F	W11-1	30	30								1		X			16.50											
		F	W11-1	30	30		11/21/14	6.25								1		X									X		
WB	0.134	F	VW-060	30	30								1	X				15.00											
		F	VW-060	30	30		11/21/14	6.25																		REQUIRES VEGETATION CLEARING			E-154
WB	0.047	F	W2-2R	30	30		11/21/14	6.25								2		15.50 X 15.75									INSTALL 250 FT EAST OF TOWN LINE RD	X		
		F	W16-8A	48	9		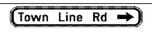	3.00																				7	
SIGN SUMMARY SHEET							SHEET TOTALS	26.75	0.00	0	0	0	3	0	0	4		77.25 ~~60.0~~		0	0.0	0.0	0.0	0.0					
								SF	SF	EA	EA	EA	EA	EA	EA	EA		FT		EA	LB	LB	LB	LB					
VERMONT AGENCY OF TRANSPORTATION							TOWN DIRECTIONAL TOTALS	~~327.16~~ ~~317.9~~	0.0	56	1	1	56	0	0	39		~~661.00~~ ~~585.0~~		0	0.0								

PROJECT NAME: ALBURGH-COLCHESTER
PROJECT NUMBER: STPG SIGN(45)
FILE NAME: 8 SOUTH HERO US2 WB TSS.x | PLOT DATE: 3/14/2014
PROJECT MANAGER: D. BRYANT | DRAWN BY: J. BLANCHARD
DESIGNED BY: B. TOOTHAKER | CHECKED K. KERN
SOUTH HERO WB SHEET 12 | SHEET 129 OF 167