DIRECTION	MILEPOINT	LOCATION CODE (SHEET 2)	SIGN CODE	WIDTH (IN)	HEIGHT (IN)	SHEETING REMARKS	SIGN LEGEND	NEW SIGNS "A"	NEW SIGNS "B"	EXISTING SIGNS RETAIN	EXISTING SIGNS SALVAGE FROM	EXISTING SIGNS SALVAGE TO	EXISTING SIGNS REMOVE	EXIST POST RETAIN	EXIST POST REMOVE	NUMBER OF NEW POSTS	SQUARE STEEL (IN) 1.75 (LB/FT) 1.88	SQUARE STEEL (IN) 2.00 (LB/FT) 2.42	SQUARE STEEL (IN) 2.50 (LB/FT) 3.35	TUBULAR STEEL Ø (IN) FOUNDATION	TUBULAR STEEL Ø (IN) 3.00 (LB/FT) 7.60	TUBULAR STEEL Ø (IN) 3.50 (LB/FT) 9.00	TUBULAR STEEL Ø (IN) 4.00 (LB/FT) 10.80	TUBULAR STEEL Ø (IN) 5.00 (LB/FT) 14.60	SIGN FRAME REQUIRED	REMARKS	SIGN DETAIL LOCATION SHSM	SIGN DETAIL LOCATION PROJECT SHEET #	SIGN DETAIL LOCATION STANDARD SHEET #
MILTON US-2 EB							FY-FLUORESCENT YELLOW FYG-FLUORESCENT YELLOW GREEN																				"SHSM"-STANDARD HIGHWAY SIGNS AND MARKINGS			
EB	3.044	A	VR-428	24	30		ALL TURNS RIGHT LANE II/18/14						1		X			15.50 16.50											
		A	R3-23	60	36		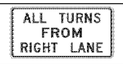	15.00								2		X								SLIP BASES	X		
EB	3.092	A	VR-903R	36	30		THRU/RIGHT ALL TURNS II/18/14						1		X														
EB	3.128	A	VR-284	30	36		ALL TURNS ===> (45 DEG) II/18/14						1		X			13.50 14.25											
		A	R3-24	72	18			9.00								2		X											
EB	3.200	A	VR-284	30	36		ALL TURNS ===> (45 DEG)						1		X														
		A	R3-24	72	18		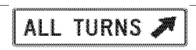	9.00								2		13.00 X 13.25											
EB	3.212	B	R3-2	24	24		NO LEFT TURN SYMBOL						1		X														
EB	3.217	B	R5-1	30	30		II/14/14						1		X			13.50											
		~~A~~	R1-1	30	30			6.25								1		X									IN MEDIAN AT INTERSECTION OF JUGHANDLE AND CUB RD (TH-40)	X		
		B	R5-1	30	30			6.25																			INSTALL ON REVERSE OF STOP SIGN	X		
EB	3.219	A	R1-1	30	30								1		X														
		B	R5-1	30	30		II/14/14						1																	
		A	R1-1	30	30			6.25								1		14.25 X									WEST OF JUGHANDLE AT INTERSECTION WITH CUB RD (TH-40)	X		
		B	R5-1	30	30			6.25																			INSTALL ON REVERSE OF STOP SIGN	X		
SIGN SUMMARY SHEET							SHEET TOTALS	58.00	0.00	0	0	0	8	0	0	8		113.75 ~~120.0~~		0	0.0	0.0	0.0	0.0					
								SF	SF	EA	EA	EA	EA	EA	EA	EA		FT		EA	LB	LB	LB	LB					
VERMONT AGENCY OF TRANSPORTATION							TOWN DIRECTIONAL TOTALS	332.1	0.0	2	0	0	42	0	0	32		480.0		0	0.0								

PROJECT NAME: **ALBURGH-COLCHESTER**
PROJECT NUMBER: **STPG SIGN(45)**
FILE NAME: **9 MILTON US2 EB TSS.xls** PLOT DATE: **3/14/2014**
PROJECT MANAGER: **D. BRYANT** DRAWN BY: **J. BLANCHARD**
DESIGNED BY: **B. TOOTHAKER** CHECKED **K. KERN**
MILTON EB SHEET 5 SHEET **134** OF **167**