DIRECTION	MILEPOINT	LOCATION CODE (SHEET 2)	SIGN CODE	WIDTH (IN)	HEIGHT (IN)	SHEETING REMARKS	SIGN LEGEND	NEW SIGNS "A"	NEW SIGNS "B"	EXISTING SIGNS RETAIN	EXISTING SIGNS SALVAGE FROM	EXISTING SIGNS SALVAGE TO	EXISTING SIGNS REMOVE	EXIST POST RETAIN	EXIST POST REMOVE	NUMBER OF NEW POSTS	SQUARE STEEL (IN) 1.75 (LB/FT) 1.88	SQUARE STEEL (IN) 2.00 (LB/FT) 2.42	SQUARE STEEL (IN) 2.50 (LB/FT) 3.35	TUBULAR STEEL Ø (IN) FOUNDATION	TUBULAR STEEL Ø (IN) 3.00 (LB/FT) 7.60	TUBULAR STEEL Ø (IN) 3.50 (LB/FT) 9.00	TUBULAR STEEL Ø (IN) 4.00 (LB/FT) 10.80	TUBULAR STEEL Ø (IN) 5.00 (LB/FT) 14.60	SIGN FRAME REQUIRED	REMARKS	SIGN DETAIL LOCATION SHSM	SIGN DETAIL LOCATION PROJECT SHEET #	SIGN DETAIL LOCATION STANDARD SHEET #
COLCHESTER US-2 EB							FY-FLUORESCENT YELLOW FYG-FLUORESCENT YELLOW GREEN																				"SHSM"-STANDARD HIGHWAY SIGNS AND MARKINGS			
EB	0.225	A	W2-1M	36	36								1		X														
		A	VW-202P	30	18								1						13.00 13.25										
		A	W2-1	48	48		11/06/14	16.00								2			X								SLIP BASES	X		
		A	VW-202P	30	24			3.75																				NEED INFO		
EB	0.263	A	D1-1M	72	12		11/04/14						1	X															
		A	VD1-1	72	12		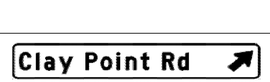	6.00																					9	
EB	0.293	A	VR-903R	36	30		THRU/RIGHT "ONLY" ALL TURNS 11/04/14						1 1		X														
EB	0.324	A	VR-284	30	36		ALL TURNS ===> (45 DEG) 11/03/14						1 1		X				12.25 13.25										
		A	R3-2	72	18											2			X										
EB	0.393	A	VR-284	36	30		ALL TURNS ===> (45 DEG) 11/04/14						1		X				11.75 12.00										
		A	R3-24	72	18			9.00									2			X									X		
EB	0.402	B	R3-2	24	24		NO LEFT TURN 11/04/14						1		X														
EB	0.408	B	R5-1	30	30								1	~~X~~													SLIP BASES			
		A	R1-1	30	30								1						12.25										
		A	R1-1	30	30			6.25									1			X								WEST OF JUGHANDLE AT INTERSECTION WITH CLAY POINT RD (TH-58)	X		
SIGN SUMMARY SHEET							SHEET TOTALS	41.00	0.00	0	0	0	~~9~~ 11	0	0	6			~~90.0~~ 87.75		0	0.0	0.0	0.0	0.0				
								SF	SF	EA	EA	EA	EA	EA	EA	EA			FT		EA	LB	LB	LB	LB				
VERMONT AGENCY OF TRANSPORTATION							TOWN DIRECTIONAL TOTALS	451.3	0.0	68	1	0	57	0	0	44			660.0		0	0.0							

PROJECT NAME: ALBURGH-COLCHESTER
PROJECT NUMBER: STPG SIGN(45)
FILE NAME: 11 COLCHESTER US2 EB TSS.
PROJECT MANAGER: D. BRYANT
DESIGNED BY: B. TOOTHAKER
COLCHESTER EB SHEET 2
PLOT DATE: 3/14/2014
DRAWN BY: J. BLANCHARD
CHECKED K. KERN
SHEET 145 OF 167