DIRECTION	MILEPOINT	LOCATION CODE (SHEET 2)	SIGN CODE	WIDTH (IN)	HEIGHT (IN)	SHEETING REMARKS	SIGN LEGEND	NEW SIGNS "A"	NEW SIGNS "B"	EXISTING SIGNS RETAIN	EXISTING SIGNS SALVAGE FROM	EXISTING SIGNS SALVAGE TO	EXISTING SIGNS REMOVE	EXIST POST RETAIN	EXIST POST REMOVE	NUMBER OF NEW POSTS	SQUARE STEEL (IN) 1.75 (LB/FT) 1.88	SQUARE STEEL (IN) 2.00 (LB/FT) 2.42	SQUARE STEEL (IN) 2.50 (LB/FT) 3.35	TUBULAR STEEL Ø (IN) FOUNDATION	TUBULAR STEEL Ø (IN) 3.00 (LB/FT) 7.60	TUBULAR STEEL Ø (IN) 3.50 (LB/FT) 9.00	TUBULAR STEEL Ø (IN) 4.00 (LB/FT) 10.80	TUBULAR STEEL Ø (IN) 5.00 (LB/FT) 14.60	SIGN FRAME REQUIRED	REMARKS	SIGN DETAIL LOCATION SHSM	SIGN DETAIL LOCATION PROJECT SHEET #	SIGN DETAIL LOCATION STANDARD SHEET #
COLCHESTER US-2 EB							FY-FLUORESCENT YELLOW FYG-FLUORESCENT YELLOW GREEN																			"SHSM"-STANDARD HIGHWAY SIGNS AND MARKINGS			
EB	0.538	A	R2-1	36	48		11/04/14						1	X				14.00											
		A	R2-1	30	36			7.50																		X		
EB	0.640	A	VD-062AS	72	16		BUSINESS SIGN			1				X															
		A	VD-062AS	72	16		BUSINESS SIGN			1																			
EB	0.803	A	VR-428	24	30		ALL TURNS RIGHT LANE 11/04/14						1		X			14.00 14.50									SLIP BASES		
		A	R3-23	60	36		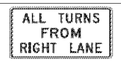	15.00								2	X											
EB	0.860	A	D1-1M	72	12								1	X															
		A	VD1-1	72	12		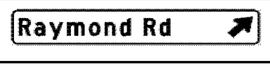 11/04/14	6.00									14.00										9	
EB	0.906	A	VR-903R	36	30		THRU/RIGHT ALL TURNS 11/04/14						1		X														
EB	0.939	A	VR-284	36	48		ALL TURNS ===> (45 DEG) 11/04/14						1		X			12.75 13.75											
		A	R3-24	72	18		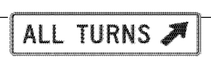	9.00								2	X										X	
EB	1.022	A	VR-284	30	36		ALL TURNS ===> (45 DEG)						1		X			12.00 12.00											
		A	R3-24	72	18			9.00								2	X										X	
EB	1.033	B	R3-2	24	24		NO LEFT TURN SYMBOL 11/04/14						1		X														
EB	1.037	A	R3-3	48	48			16.00								2	10.75 X 11.25										INSTALL IN MEDIAN AT INTERSECTION OF RTE 2 AND RAYMOND RD RD (TH-40)	X		
							SHEET TOTALS	62.50	0.00	2	0	0	~~8~~ 7	0	0	8	~~129.0~~ 120.0		0	0.0	0.0	0.0	0.0				
								SF	SF	EA	EA	EA	EA	EA	EA	EA	FT		EA	LB	LB	LB	LB				
							TOWN DIRECTIONAL TOTALS	451.3	0.0	68	1	0	57	0	0	44	660.0		0	0.0							

SIGN SUMMARY SHEET

VERMONT AGENCY OF TRANSPORTATION

PROJECT NAME: ALBURGH-COLCHESTER
PROJECT NUMBER: STPG SIGN(45)

FILE NAME: 11 COLCHESTER US2 EB TSS.
PROJECT MANAGER: D. BRYANT
DESIGNED BY: B. TOOTHAKER
COLCHESTER EB SHEET 4

PLOT DATE: 3/14/2014
DRAWN BY: J. BLANCHARD
CHECKED K. KERN
SHEET 147 OF 167