DIRECTION	MILEPOINT	LOCATION CODE (SHEET 2)	SIGN CODE	WIDTH (IN)	HEIGHT (IN)	SHEETING REMARKS	SIGN LEGEND	NEW SIGNS "A"	NEW SIGNS "B"	EXISTING SIGNS RETAIN	EXISTING SIGNS SALVAGE FROM	EXISTING SIGNS SALVAGE TO	EXISTING SIGNS REMOVE	EXIST POST RETAIN	EXIST POST REMOVE	NUMBER OF NEW POSTS	SQUARE STEEL (IN) 1.75 / 2.00 / 2.50 (LB / FT) 1.88 / 2.42 / 3.35	TUBULAR STEEL Ø (IN) 3.00 / 3.50 / 4.00 / 5.00 (LB / FT) FOUNDATION 7.60 / 9.00 / 10.80 / 14.60	SIGN FRAME REQUIRED	REMARKS	SIGN DETAIL LOCATION SHSM	PROJECT SHEET #	STANDARD SHEET #
NB WOODSTOCK VT 12							FY-FLUORESCENT YELLOW FYG-FLUORESCENT YELLOW GREEN													"SHSM"-STANDARD HIGHWAY SIGNS AND MARKINGS			
NB	1.114	A	VD1-1AS	72	12		SUICIDE SIX SKI AREA 2 ---> (45 DEG) (CONT.)			1													
		A	M3-1	24	12		NORTH			1													
		A	M1-5	24	24		VT ROUTE 12			1													
		A	M6-2	21	15		<--- LEFT (45 DEG)			1													
NB	1.120	B	W1-6R	48	24								1		X					THIS SIGN FACES SB TRAFFIC			
		B	W1-6R	48	24		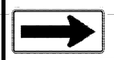	8.00								2	14.0'/15.5' X				X		
NB	1.129	B	W1-6R	48	24								1		X					THIS SIGN FACES SB TRAFFIC			
		B	W1-6R	48	24		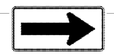	8.00								2	13.5'/14.0' X				X		
NB	1.131	A	D3-1	24	6		POMFRET RD TH01						1		X					REMOVE BOTH SIGNS AND THE POST; ON THE LEGAL LOAD LIMIT SIGN SIDE OF THE INTERSECTION			
		C	D3-1	24	6		POMFRET RD TH01						1							NOTE: BOTH STREET SIGNS REFERENCE POMFRET RD			
NB	1.131	C	VR-017	24	30		LEGAL LOAD LIMIT 24,000 POUNDS						1		X					POMFRET RD (TH-1)			
		C	R2-1	18	24		SPEED LIMIT 35				1		1							TOWN INSTALLED SIGN TO BE SALVAGED ONTO THE NEW POST UNDER THE NEW LEGAL LOAD LIMIT SIGN			
		C	VR-017	24	30			5.00								1	16.5' X			~~ADJUST THE ASSEMBLY CLOSER TO THE INTERSECTION WITH VT ROUTE 12.~~		6	
		C	R2-1	18	24		SPEED LIMIT 35					1								SALVAGE TO BELOW THE NEW LEGAL LOAD LIMIT SIGN			
NB	1.146	D	R1-1	30	30		STOP (CONT. ON NEXT PAGE)						1		X					POMFRET RD (TH-1)			
							SHEET TOTALS	21.00	0.00	4	1	1	7	0	0	5	~~73.5~~ ~~75.0~~	0	0.0	0.0	0.0	0.0	
								SF	SF	EA	EA	EA	EA	EA	EA	EA	FT	EA	LB	LB	LB	LB	
							TOWN DIRECTIONAL TOTALS	126.3	0.0	12	6	6	32	0	0	24	360.0	0	0.0				

SIGN SUMMARY SHEET

VERMONT AGENCY OF TRANSPORTATION

PROJECT NAME: **HARTLAND-BETHEL**
PROJECT NUMBER: **STPG SIGN (40)**
FILE NAME: **WOODSTOCK VT ROUTE 12 NE**
PROJECT MANAGER: **AMY GAMBLE**
DESIGNED BY: **M. MILLER**
WOODSTOCK VT-12 NORTHBOUND 2
PLOT DATE: **8/1/2012**
DRAWN BY: **M. MILLER**
CHECKED **AMY GAMBLE**
SHEET **36** OF **85**