| DIRECTION | MILEPOINT | LOCATION CODE (SHEET 2) | SIGN CODE | WIDTH (IN) | HEIGHT (IN) | SHEETING REMARKS | SIGN LEGEND | NEW SIGNS "A" | NEW SIGNS "B" | EXISTING SIGNS RETAIN | EXISTING SIGNS SALVAGE FROM | EXISTING SIGNS SALVAGE TO | EXISTING SIGNS REMOVE | EXIST POST RETAIN | EXIST POST REMOVE | NUMBER OF NEW POSTS | SQUARE STEEL (IN) 1.75 (LB / FT) 1.88 | SQUARE STEEL (IN) 2.00 (LB / FT) 2.42 | SQUARE STEEL (IN) 2.50 (LB / FT) 3.35 | FOUNDATION | TUBULAR STEEL Ø (IN) 3.00 (LB / FT) 7.60 | TUBULAR STEEL Ø (IN) 3.50 (LB / FT) 9.00 | TUBULAR STEEL Ø (IN) 4.00 (LB / FT) 10.80 | TUBULAR STEEL Ø (IN) 5.00 (LB / FT) 14.60 | SIGN FRAME REQUIRED | REMARKS | SIGN DETAIL LOCATION SHSM | SIGN DETAIL LOCATION PROJECT SHEET # | SIGN DETAIL LOCATION STANDARD SHEET # |
|---|---|---|---|---|---|---|---|---|---|---|---|---|---|---|---|---|---|---|---|---|---|---|---|---|---|---|---|---|---|
| **READSBORO VT-8 SB** | | | | | | | FY-FLUORESCENT YELLOW<br>FYG-FLUORESCENT YELLOW GREEN | | | | | | | | | | | | | | | | | | | "SHSM"-STANDARD HIGHWAY SIGNS AND MARKINGS | | | |
| | | F | M1-5 | 30 | 24 | | | | | | | | 1 | | | | | | | | | | | | | | | | |
| | | F | M6-1 | 21 | 15 | | | | | | | | 1 | | | | | | | | | | | | | | | | |
| | | F | M3-1 | 24 | 12 | | | 2.00 | | | | | | | | | | | | | | | | | | | | | E-136B |
| | | F | M1-5 | 30 | 24 | | | 5.00 | | | | | | | | | | | | | | | | | | | | | E-136B |
| | | F | M6-1L | 21 | 15 | | | 2.19 | | | | | | | | | | | | | | | | | | | | | E-136B |
| | | F | M3-3 | 24 | 12 | | | 2.00 | | | | | | | | | | | | | | | | | | | | | E-136B |
| | | F | M1-5 | 24 | 24 | | | 4.00 | | | | | | | | | | | | | | | | | | | | | E-136B |
| | | F | M6-1R | 21 | 15 | | | 2.19 | | | | | | | | | | | | | | | | | | | | | E-136B |
| | | F | M3-3 | 24 | 12 | | 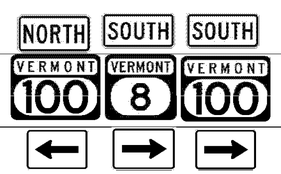  | 2.00 | | | | | | | | | | | | | | | | | | | | E-136B |
| | | F | M1-5 | 30 | 24 | | | 5.00 | | | | | | | | | | | | | | | | | | | | | E-136B |
| | | F | M6-1R | 21 | 15 | | | 2.19 | | | | | | | | | | | | | | | | | | | | | E-136B |
| | | E | VD-700 | 6 | 10 | | | | | | | | 1 | | | | | | | | | | | | | | | | |
| SB | 0.009 | F | R1-1 | 30 | 30 | | | | | | | | 1 | | X | | | | | | | | | | | | | | |
| | E | E | VD-700 | 6 | 10 | | 1000 0209 0219 | 0.42 | | | | | | | | | | | | | | | | | | | | | |
| | | F | R1-1 | 30 | 30 | | | 6.25 | | | | | | | | 1 | | 14'-2" X | | | | | | | | | X | | |
| | | | | | | | | | | | | | | | | | | | | | | | | | | | | | |
| | | | | | | | | | | | | | | | | | | | | | | | | | | | | | |
| **SIGN SUMMARY SHEET** | | | | | | | SHEET TOTALS | 33.24 ~~32.82~~ | 0.00 | 0 | 0 | 0 | 4 ~~3~~ | 0 | 0 | 1 | 15.0 | | | 0 | 0.0 | 0.0 | 0.0 | 0.0 | | | | | |
| | | | | | | | | SF | SF | EA | EA | EA | EA | EA | EA | EA | FT | | | EA | LB | LB | LB | LB | | | | | |
| VERMONT AGENCY OF TRANSPORTATION | | | | | | | TOWN DIRECTIONAL TOTALS | 124.27 ~~123.4~~ | 0.0 | 1 | 0 | 0 | 27 | 0 | 0 | 12 | 180.0 | | | 0 | 0.0 | | | | | | | | |

PROJECT NAME: STATEWIDE SOUTHWEST REGION
PROJECT NUMBER: STPG SIGN(41)

FILE NAME: 12C118
PROJECT MANAGER: A. GAMBLE
DESIGNED BY: J. KELLY
READSBORO SB SHEET 4

PLOT DATE: 2/13/2013
DRAWN BY: J. KELLY
CHECKED A. GAMBLE