DIRECTION	MILEPOINT	LOCATION CODE (SHEET 2)	SIGN CODE	WIDTH (IN)	HEIGHT (IN)	SHEETING REMARKS	SIGN LEGEND	NEW SIGNS "A"	NEW SIGNS "B"	EXISTING SIGNS RETAIN	EXISTING SIGNS SALVAGE FROM	EXISTING SIGNS SALVAGE TO	EXISTING SIGNS REMOVE	EXIST POST RETAIN	EXIST POST REMOVE	NUMBER OF NEW POSTS	SQUARE STEEL (IN) 1.75 (LB / FT) 1.88	SQUARE STEEL (IN) 2.00 (LB / FT) 2.42	SQUARE STEEL (IN) 2.50 (LB / FT) 3.35	FOUNDATION	TUBULAR STEEL Ø (IN) 3.00 (LB / FT) 7.60	TUBULAR STEEL Ø (IN) 3.50 (LB / FT) 9.00	TUBULAR STEEL Ø (IN) 4.00 (LB / FT) 10.80	TUBULAR STEEL Ø (IN) 5.00 (LB / FT) 14.60	SIGN FRAME REQUIRED	REMARKS	SIGN DETAIL LOCATION SHSM	SIGN DETAIL LOCATION PROJECT SHEET #	SIGN DETAIL LOCATION STANDARD SHEET #
SEARSBURG VT-8 SB							FY-FLUORESCENT YELLOW FYG-FLUORESCENT YELLOW GREEN																				"SHSM"-STANDARD HIGHWAY SIGNS AND MARKINGS			
		F	D2-1	72	10		READSBORO 11						1														ANCHORS IN LEDGE			
SB	2.542	F	W1-5L	30	30		WINDING ROAD LEFT						1		X														
		F	W13-1	18	18		35 MPH ADVISORY						1																
SB	2.510	F	W11-21	30	30		MOOSE SYMBOL						1	X															
		F	W7-3A	24	18								1																
		F	VW-000	30	30			6.25																INSTALL NEW SIGNS ON EXISTING FLANGED CHANNEL SIGN POST.		7	
		F	W7-3aP	24	18			3.00																				X		
SB	2.335	F	W1-10L	36	36		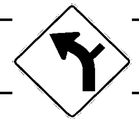	9.00								2	15'-1" 15'-0" X										INSTALL ON NORTH SIDE OF FIELD DRIVE, APPROX. 235 FT NORTH OF PUTNAM RD.	X		
SB	2.291	G	VR-017	24	30								1		X												PUTNAM RD (TH-2)			
		G	VR-017	24	30			5.00								1	14'-5" X												6	
		F	D3-1	UNK	UNK		PUTNAM RD STREET SIGN						1																
SB	2.282	H	R1-1	30	30								1		X												PUTNAM RD (TH-2)			
		F	D3-1	42	12			3.50																			INSTALL STREET SIGN ON TOP OF STOP SIGN USING BRACKET.		11	
		H	R1-1	30	30			6.25								1	13'-0" X											X		
SB	1.800	F	S3-1T	30	30		SCHOOL BUS STOP AHEAD						1		X														
SIGN SUMMARY SHEET							SHEET TOTALS	33.00	0.00	0	0	0	9	0	0	4	60.0			0	0.0	0.0	0.0	0.0					
								SF	SF	EA	EA	EA	EA	EA	EA	EA	FT			EA	LB	LB	LB	LB					
VERMONT AGENCY OF TRANSPORTATION							TOWN DIRECTIONAL TOTALS	121.5	0.0	0	0	0	~~30~~ 29	0	0	19	285.0			0	0.0								

PROJECT NAME: **STATEWIDE SOUTHWEST REGION**
PROJECT NUMBER: **STPG SIGN(41)**

FILE NAME: **12C118**
PROJECT MANAGER: **A. GAMBLE**
DESIGNED BY: **J. KELLY**
SEARSBURG SB SHEET 2

PLOT DATE: **2/13/2013**
DRAWN BY: **J. KELLY**
CHECKED **A. GAMBLE**
SHEET **26** OF **97**