| DIRECTION | MILEPOINT | LOCATION CODE (SHEET 2) | SIGN CODE | WIDTH (IN) | HEIGHT (IN) | SHEETING REMARKS | SIGN LEGEND | NEW SIGNS "A" | NEW SIGNS "B" | EXISTING SIGNS RETAIN | EXISTING SIGNS SALVAGE FROM | EXISTING SIGNS SALVAGE TO | EXISTING SIGNS REMOVE | EXIST POST RETAIN | EXIST POST REMOVE | NUMBER OF NEW POSTS | SQUARE STEEL (IN) 1.75 (LB / FT) 1.88 | SQUARE STEEL (IN) 2.00 (LB / FT) 2.42 | SQUARE STEEL (IN) 2.50 (LB / FT) 3.35 | FOUNDATION | TUBULAR STEEL Ø (IN) 3.00 (LB / FT) 7.60 | TUBULAR STEEL Ø (IN) 3.50 (LB / FT) 9.00 | TUBULAR STEEL Ø (IN) 4.00 (LB / FT) 10.80 | TUBULAR STEEL Ø (IN) 5.00 (LB / FT) 14.60 | SIGN FRAME REQUIRED | REMARKS | SIGN DETAIL LOCATION SHSM | SIGN DETAIL LOCATION PROJECT SHEET # | SIGN DETAIL LOCATION STANDARD SHEET # |
|---|---|---|---|---|---|---|---|---|---|---|---|---|---|---|---|---|---|---|---|---|---|---|---|---|---|---|---|---|---|
| **SEARSBURG VT-8 SB** | | | | | | | FY-FLUORESCENT YELLOW<br>FYG-FLUORESCENT YELLOW GREEN | | | | | | | | | | | | | | | | | | | "SHSM"-STANDARD HIGHWAY SIGNS AND MARKINGS | | | |
| SB | 0.232 | F | W1-4R | 30 | 30 | | | 6.25 | | | | | | | | 1 | | 14'-4" X | | | | | | | | INSTALL 660 FEET SOUTH OF EXISTING RIGHT REVERSE CURVE SIGN ASSEMBLY. | X | | |
| SB | 0.200 | F | W7-1 | 30 | 30 | | HILL SYMBOL | | | | | | 1 | | X | | | | | | | | | | | | | | |
| SB | 0.095 | F | W1-4R | 30 | 30 | | RIGHT REVERSE CURVE | | | | | | 1 | | X | | | | | | | | | | | | | | |
| | | F | W13-1 | 18 | 18 | | 35 MPH ADVISORY | | | | | | 1 | | | | | | | | | | | | | | | | |
| | | F | W7-1a | 30 | 30 | | | 6.25 | | | | | | | | 1 | | 18'-3" X | | | | | | | | | X | | |
| | | F | W7-3aP | 24 | 18 | | 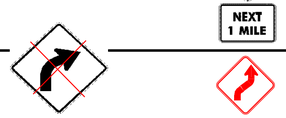 | 3.00 | | | | | | | | | | | | | | | | | | | X | | |
| SB | 0.010 | F | W1-4R | 30 | 30 | | | 6.25 | | | | | | | | 1 | | 15'-0" X | | | | | | | | INSTALL 50 FEET NORTH OF AND ACROSS FROM TOWN LINE SIGN. | X | | |
| | | | | | | | SHEET TOTALS | 21.75 SF | 0.00 SF | 0 EA | 0 EA | 0 EA | 3 EA | 0 EA | 0 EA | 3 EA | | 45.0 FT | | 0 EA | 0.0 LB | 0.0 LB | 0.0 LB | 0.0 LB | | | | |
| | | | | | | | TOWN DIRECTIONAL TOTALS | 121.5 | 0.0 | 0 | 0 | 0 | ~~30~~ 29 | 0 | 0 | 19 | | 285.0 | | 0 | 0.0 | | | | | | | |

## SIGN SUMMARY SHEET

VERMONT AGENCY OF TRANSPORTATION

PROJECT NAME: STATEWIDE SOUTHWEST REGION
PROJECT NUMBER: STPG SIGN(41)

FILE NAME: 12C118
PROJECT MANAGER: A. GAMBLE
DESIGNED BY: J. KELLY
SEARSBURG SB SHEET 4

PLOT DATE: 2/13/2013
DRAWN BY: J. KELLY
CHECKED A. GAMBLE
SHEET 28 OF 97