DIRECTION	MILEPOINT	LOCATION CODE (SHEET 2)	SIGN CODE	WIDTH (IN)	HEIGHT (IN)	SHEETING REMARKS	SIGN LEGEND	NEW SIGNS "A"	NEW SIGNS "B"	EXISTING SIGNS RETAIN	EXISTING SIGNS SALVAGE FROM	EXISTING SIGNS SALVAGE TO	EXISTING SIGNS REMOVE	EXIST POST RETAIN	EXIST POST REMOVE	NUMBER OF NEW POSTS	SQUARE STEEL (IN) 1.75 (LB / FT) 1.88	SQUARE STEEL (IN) 2.00 (LB / FT) 2.42	SQUARE STEEL (IN) 2.50 (LB / FT) 3.35	FOUNDATION	TUBULAR STEEL Ø (IN) 3.00 (LB / FT) 7.60	TUBULAR STEEL Ø (IN) 3.50 (LB / FT) 9.00	TUBULAR STEEL Ø (IN) 4.00 (LB / FT) 10.80	TUBULAR STEEL Ø (IN) 5.00 (LB / FT) 14.60	SIGN FRAME REQUIRED	REMARKS	SIGN DETAIL LOCATION SHSM	SIGN DETAIL LOCATION PROJECT SHEET #	SIGN DETAIL LOCATION STANDARD SHEET #
JAMAICA VT-30 NB							FY-FLUORESCENT YELLOW FYG-FLUORESCENT YELLOW GREEN																			"SHSM"-STANDARD HIGHWAY SIGNS AND MARKINGS			
NB	3.732	A	VD-062BRN	72	16		BUSINESS SIGN			1				X														
NB	~~3.658~~ 3.606	A	W11-2	30	30	FYG		6.25								1		13'-11" X								INSTALL BETWEEN GRANITE POSTS BETWEEN #3632 & #3606.	X		
		A	W16-9P	24	12	FYG		2.00																			X		
NB	3.785	C	VR-017	24	30								1	X													DEPOT ST (TH-19)			
		C	VR-017	24	30			5.00																			INSTALL ON EXISTING POST.		6	
NB	3.787	D	R1-1	30	30								1		X												DEPOT ST (TH-19)			
		D	R1-1	30	30			6.25								1		9'-6" X								USED EXISTING ANCHOR INSTALL IN ISLAND.	X		
NB	3.787	D	D3-1	UNK	UNK		STREET NAME SIGN.						1		X												LOCATED IN ISLAND.			
		D	D3-1	44	12		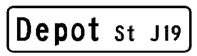	3.67								2		11'-9" 11'-9" X								INSTALL IN ISLAND. DO NOT BLOCK STOP SIGN.		11	
NB	3.795	D	R1-1	30	30					~~1~~			~~1~~		~~X~~												DEPOT ST (TH-19)			
		D	R1-1	30	30			6.25								~~1~~		~~X~~									X		
NB	3.810	A	R2-1	24	30			5.00								~~1~~		~~X~~								INSTALL NEAR DROP INLET AT TANGENT OF SLIP-LANE. ON EXISTING POST	X		
NB	3.810	A	R8-3	24	24			4.00								~~1~~		~~X~~								INSTALL ASSEMBLY UNDERNEATH ~~INSTALL TO RIGHT OF SPEED LIMIT~~ 30 ~~SIGN ASSEMBL~~Y.	X		
		A	VR-122	24	12			2.00																		SPEED LIMIT 30 SIGN ON SAME POST		6	
NB	3.853	C	VR-017	24	24								1	X													FACTORY ST (TH-50)			
SIGN SUMMARY SHEET							SHEET TOTALS	~~34.17~~ ~~40.42~~ SF	0.00 SF	~~2~~ ~~1~~ EA	0 EA	0 EA	~~4~~ ~~5~~ EA	0 EA	0 EA	~~4~~ ~~7~~ EA	~~60.0~~ ~~105.0~~ FT		0 EA	0.0 LB	0.0 LB	0.0 LB	0.0 LB					
VERMONT AGENCY OF TRANSPORTATION							TOWN DIRECTIONAL TOTALS	~~438.5~~ ~~443.5~~	0.0	~~32~~ ~~29~~	~~2~~ ~~1~~	~~2~~ ~~1~~	~~88~~ ~~78~~	0	0	~~63~~ ~~62~~	~~945.0~~ ~~930.0~~		0	0.0							

PROJECT NAME: **STATEWIDE SOUTHWEST REGION**
PROJECT NUMBER: **STPG SIGN(41)**

FILE NAME: **12C118**
PROJECT MANAGER: **A. GAMBLE**
DESIGNED BY: **J. KELLY**
JAMAICA NB SHEET 6

PLOT DATE: **2/13/2013**
DRAWN BY: **J. KELLY**
CHECKED **A. GAMBLE**
SHEET **34** OF **97**