DIRECTION	MILEPOINT	LOCATION CODE (SHEET 2)	SIGN CODE	WIDTH (IN)	HEIGHT (IN)	SHEETING REMARKS	SIGN LEGEND	NEW SIGNS		EXISTING SIGNS				EXIST POST		NUMBER OF NEW POSTS	SQUARE STEEL (IN)			TUBULAR STEEL Ø (IN)				SIGN FRAME REQUIRED	REMARKS	SIGN DETAIL LOCATION		
								"A"	"B"	RETAIN	SALVAGE FROM	SALVAGE TO	REMOVE	RETAIN	REMOVE		1.75 (LB / FT) 1.88	2.00 (LB / FT) 2.42	2.50 (LB / FT) 3.35	FOUNDATION	3.00 (LB / FT) 7.60	3.50 (LB / FT) 9.00	4.00 (LB / FT) 10.80	5.00 (LB / FT) 14.60			SHSM	PROJECT SHEET #	STANDARD SHEET #
JAMAICA VT-30 SB							FY-FLUORESCENT YELLOW FYG-FLUORESCENT YELLOW GREEN																		"SHSM"-STANDARD HIGHWAY SIGNS AND MARKINGS			
		F	M1-5	24	24								1															
		F	M6-3	21	15								1															
		F	M3-3	24	12								1															
		F	M1-5	30	24								1															
		F	M6-3	21	15								1															
		F	M3-1	24	12			2.00								2			10'-3" 10'-3" X						#3B			5	E-136B
		F	M1-5	30	24			5.00																				E-136B
		F	M6-1L	21	15			2.19																				E-136B
		F	M3-3	24	12			2.00																				E-136B
		F	M1-5	24	24			4.00																				E-136B
		F	M6-3	21	15			2.19																				E-136B
		F	M3-3	24	12		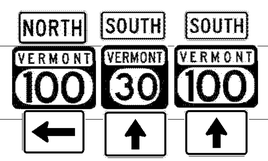	2.00																				E-136B
		F	M1-5	30	24			5.00																				E-136B
		F	M6-3	21	15			2.19																				E-136B
SB	8.810	F	W1-7	48	24								1		X													
							SHEET TOTALS	26.57	0.00	0	0	0	6	0	0	2		30.0		0	0.0	0.0	0.0	0.0					
								SF	SF	EA	EA	EA	EA	EA	EA	EA		FT		EA	LB	LB	LB	LB					
							TOWN DIRECTIONAL TOTALS	431.84 ~~430.2~~	0.0	31 ~~29~~	2 ~~0~~	2 ~~0~~	85 ~~82~~	0	0	66 ~~63~~		990.0 ~~945.0~~		0	0.0								

SIGN SUMMARY SHEET

VERMONT AGENCY OF TRANSPORTATION

PROJECT NAME: **STATEWIDE SOUTWEST REGION**
PROJECT NUMBER: **STPG SIGN(41)**

FILE NAME: **12C118**
PROJECT MANAGER: **A. GAMBLE**
DESIGNED BY: **J. KELLY**
JAMAICA SB SHEET 3

PLOT DATE: **2/13/2013**
DRAWN BY: **J. KELLY**
CHECKED **A. GAMBLE**
SHEET **45** OF **97**